

MISSISSIPPI
 BOARD OF WATER COMMISSIONERS
 416 North State Street
 Jackson, Mississippi 39201

WATER WELL DRILLERS LOG

CODED

Quitman.
 J 30
 3-69

3-6-69 date well completed
 Five County Farmers Assn firm name
 Quitman county well located

LANDOWNER: F R TRAINOR
 LAMBERT MISS
 (mailing address)

description of formations encountered	from	to
Clay Top Soil		21'
Fine Sand	21	46
Coarse Sand & Pea Rock	46	95

WELL LOCATION:
 sec 19 T 27 N R 1 E
 2 miles E of Lambert
 (distance) (direction) (nearest town)

WELL PURPOSE:
 (home, irrigation, municipal, industrial)

WELL COMPLETION DATA:

(1) diameter (inches) 2"
 (2) total depth (feet) 90
 (3) static water level (feet) 22' 4" below top of ground.
 (4) casing 2" SV (material), 84' (depth)
 (size) if telescope see back.
 (5) screen 6' (length), 84' (depth to top)
 2" (size) Bronze wrapped (material)
 (6) pump 1/3 (HP), 6 (yield gpm)
 Elec (type power)
 (7) electric log NO (yes or no)
 (organization running log)
 (8) how well bottom plugged POINT

CODED


MAR 10 1969

DRILLERS REMARKS:

MISS. DEPT. OF
 WATER CONTROL
 WATER DIVISION

If well telescopes please sketch and show depths.

GROUND LEVEL

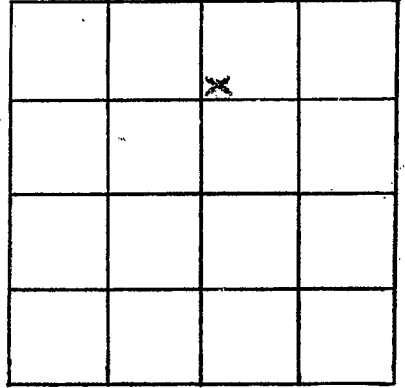

SECTION 19

Please indicate well location X.

ADDITIONAL INFORMATION

If more than one screen, show locations of each on sketch.