

Quietman
 J 311
 12-68

MISSISSIPPI
 BOARD OF WATER COMMISSIONERS
 416 North State Street
 Jackson, Mississippi 39201

CODED
 CODED

WATER WELL DRILLERS LOG

Quietman
~~James R. Life~~

date well completed 19 68 firm name James R. Life county well located Quitman

LANDOWNER: M. Sutton

description of formations encountered	from	to
Clay	0	20
sand	20	40
"	40	60
sand and gravel	60	80
" " "	80	100
Clay	100	120
"	120	140
sand and clay	140	160
sand	160	180
"	180	200
"	200	220
"	220	230
Clay	230	240
Clay and rocks	240	260
sand clay and rocks	260	280
sand and clay	280	300
good sand	300	320
sand and clay	320	340
" " "	340	360
" " "	360	380
" " "	380	400
Clay	400	420
"	420	440
Clay and sand	440	460
good sand	460	480
"	480	500
"	500	520
"	520	540
"	540	560

Crowder Miss.
 (mailing address)

WELL LOCATION:
 sec 27 T 27 N R 1 E S W
2 miles west of Crowder
 (distance) (direction) (nearest town)

WELL PURPOSE: home
 (home, irrigation, municipal, industrial)

WELL COMPLETION DATA:

- (1) diameter (inches) 3"
- (2) total depth (feet) 660
- (3) static water level (feet) flowing below top of ground.
- (4) casing galv 530
 (material) (depth)
 (size) If telescope see back.
- (5) screen 30' 530
 (length) (depth to top)
3' S.S.
 (size) (material)
- (6) pump 30
 (HP) (yield gpm)
 (type power)
- (7) electric log (yes or no) _____
 (organization running log) _____
- (8) how well bottom plugged _____


DRILLERS REMARKS: Cut 1st rock at 230'

CODED

JAN 10 1969
 MISSISSIPPI WATER COMMISSION
 JACKSON, MISSISSIPPI

If well telescopes please sketch and show depths.

GROUND LEVEL

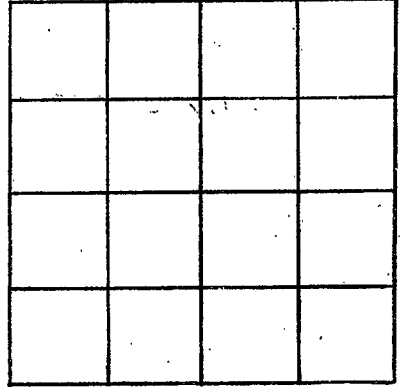

SECTION 27

Please indicate well location X.

ADDITIONAL INFORMATION

If more than one screen,
show locations of each on sketch.