

QUITMAN MISSISSIPPI BOARD OF WATER COMMISSIONERS

J36

4-10-65

WATER WELL DRILLERS LOG

**CODED**

Date: 4-10-65, 1965, Driller: J. B. Cain County Parola

Marquis (Name)

(1) Owner of Land	Description & Color of Materials Sand, Clay, Red Clay, Shell, etc.	Thick- ness Feet	Depth Feet
<u>Huland Thomas</u> (Name)	<u>Blue Clay</u>	<u>0</u>	<u>60</u>
<u>Crowder</u> (Address)	<u>Sand</u>	<u>0</u>	<u>150</u>
(2) Location: <u>1/4</u> , <u>1/4</u> , Sec. <u>14</u> <u>T27R1E</u>	<u>Blue Clay</u>	<u>0</u>	<u>300</u>
<u>7</u> miles <u>W</u> of <u>Crowder</u> (distance) (direction) (Nearest Town)	<u>Sand</u>	<u>300</u>	<u>490</u>
(3) Topography: _____ (Hilly) (Flat) (Level)			
(4) Purpose of Well: <u>Home</u> (Domestic Irrigation Municipal, Industrial, Other)			

Information upon completion of well:


- (1) Diameter 2 inches.
- (2) Total Depth 490 feet.
- (3) Water Level Flow feet below top of ground.
- (4) Cased to 420 size NO  
Open Bottom
- (5) Screen: Size \_\_\_\_\_, Length \_\_\_\_\_.
- (6) Were any formations sealed against pollution?  
\_\_\_\_\_ yes, \_\_\_\_\_ no.

If YES depth of formation \_\_\_\_\_  
Why \_\_\_\_\_

Drillers Remarks: \_\_\_\_\_

*Coded*

**CODED**

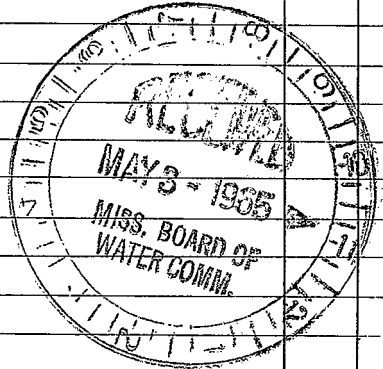

Well No. \_\_\_\_\_

(Use Back Side)

1933