

QUITMAN  
 Q 39  
 8-68

MISSISSIPPI  
 BOARD OF WATER COMMISSIONERS  
 416 North State Street  
 Jackson, Mississippi 39201

CODED

WATER WELL DRILLERS LOG

8-1-68 date well completed  
 Five County Farmers Assoc firm name  
 Quitman county well located

LANDOWNER: ER TRAYNOR

Lambert

Miss

(mailing address)

description of formations encountered

from to

Clay		10
fine sand	10	35
Coarse sand & pebbles	35	95

WELL LOCATION:

sec 8 T 27 N R 1 E

4 1/2 miles NE of Lambert  
 (distance) (direction) (nearest town)

WELL PURPOSE: Domestic  
 (home, irrigation, municipal, industrial)

WELL COMPLETION DATA:

(1) diameter (inches) 2

(2) total depth (feet) 90

(3) static water level (feet) 18 9 below top of ground.

(4) casing 4" pipe 8 ft  
 (material) (depth)

7 (size) if telescope see back.

(5) screen 2" x 6" 8 ft  
 (length) (depth to top)

7 (size) bronze plated (material)

(6) pump None  
 (HP) (yield gpm)

(type power)


(7) electric log No  
 (yes or no)

(organization running log)

(8) how well bottom plugged Screen  
 80125


DRILLERS REMARKS:

CODED

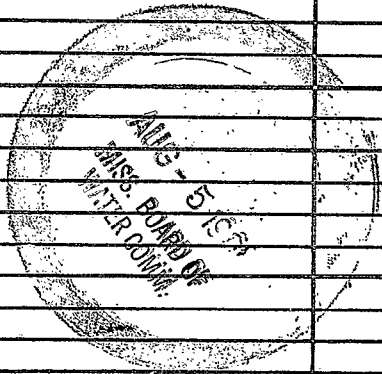

If well telescopes please sketch and show depths.

GROUND LEVEL

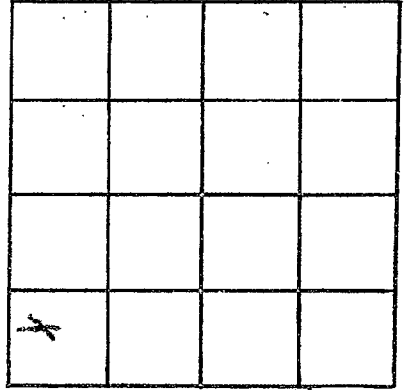

SECTION \_\_\_\_\_

Please indicate well location X.

ADDITIONAL INFORMATION

If more than one screen, show locations of each on sketch.