

Quitman
J 42
6-28-75

MISSISSIPPI
 BOARD OF WATER COMMISSIONERS
 416 North State Street
 Jackson, Mississippi 39201

CODED
 Quitman

WATER WELL DRILLERS LOG

6-28-75 19
 date well completed

J B Cain
 firm name
Big Spring

~~Quitman~~
 county well located

LANDOWNER Mr Warrington
Crowder Mrs
Warrington's Store
 (mailing address)

description of formations encountered	from	to
Gumbo Clay	0	15'
Sand	15	30

WELL LOCATION:

sec. 27 T. 27 N. 1 E. 15 F.
2 miles N of Crowder
 (distance) (direction) (nearest town)

WELL PURPOSE: Home
 (home, irrigation, municipal, industrial)


CODED

WELL COMPLETION DATA:

- (1) diameter (inches) 4"
- (2) total depth (feet) 30
- (3) static water level (feet) 12 below top of ground.
- (4) casing Plastic 30
 (material) (depth)
4" if telescope see back.
 (size)
- (5) screen 10' 40'
 (length) (depth to top)
4" Plastic
 (size) (material)
- (6) pump 1/2 15
 (HP) (yield gpm)
ELect
 (type power)
- (7) electric log No
 (yes or no)

N
 (organization running log)


(8) how well bottom plugged Plug W.B.

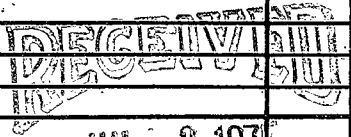

DRILLERS REMARKS
U. Cain

If well telescopes please sketch and show depths.

GROUND LEVEL

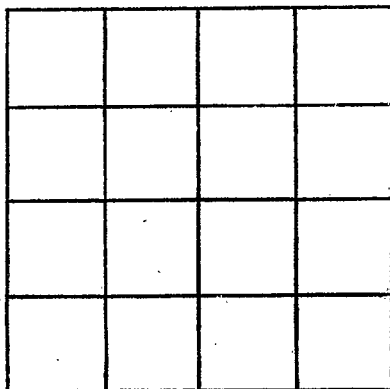

SECTION _____

Please indicate well location X.

ADDITIONAL INFORMATION

If more than one screen, show locations of each on sketch.