

Quitman  
J 43  
3-27-75

MISSISSIPPI  
BOARD OF WATER COMMISSIONERS  
416 North State Street  
Jackson, Mississippi 39201

WATER WELL DRILLERS LOG CODED

*Singer-Rayne*  
Rufus Wright

May 27, 1975  
date well completed

Rufus Wright  
firm name

Quitman  
county well located

LANDOWNER: <u>Rufus Wright</u> Rt. 3, Box 144 Lambert, Mississippi (mailing address)	description of formations encountered	from	to
WELL LOCATION: sec. <u>19</u> T <u>27</u> N R <u>1</u> E & <u>East</u> <u>South</u> 4 miles of Lambert (distance) (direction) (nearest town)			
WELL PURPOSE: <u>irrigation</u> (home, irrigation, municipal, industrial)	Fine sand	12	38'
WELL COMPLETION DATA: (1) diameter (inches) <u>16"</u>	Coarse sand	38	65'
(2) total depth (feet) <u>100'</u>	Gravel	65	100'
(3) static water level (feet) <u>7</u> below top of ground.			
(4) casing <u>Steel</u> <u>40'</u> (material) (depth) <u>16"</u> if telescope see back. (size)			
(5) screen <u>60'</u> <u>60'</u> (length) (depth to top) <u>16"</u> <u>Steel</u> (size) (material)			
(6) pump <u>60</u> <u>2800-3000</u> (HP) (yield gpm) <u>engine</u> (type power)			
(7) electric log <u>no</u> (yes or no) <u>(organization running log)</u>			
(8) how well bottom plugged <u>steel plate</u>			
DRILLERS REMARKS:			


CODED

RECEIVED  
JUL 14 1975

MISS. BD. OF WATER COMMISSIONERS

If well telescopes please sketch and show depths.

GROUND LEVEL

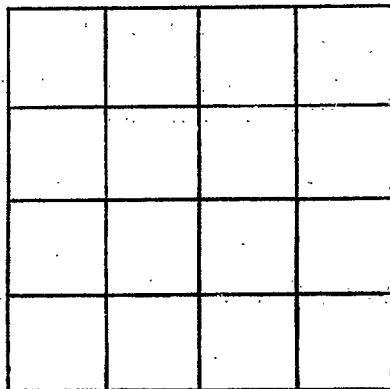

SECTION \_\_\_\_\_

Please indicate well location X.

ADDITIONAL INFORMATION

If more than one screen, show locations of each on sketch.