

Quitman  
J 44  
6-23-75

MISSISSIPPI  
BOARD OF WATER COMMISSIONERS  
416 North State Street  
Jackson, Mississippi 39201

WATER WELL DRILLERS LOG

CODED

June 23, 1975  
date well completed

Singer - Payne  
Rufus Wright  
firm name

Quitman  
county well located


LANDOWNER: Rufus Wright Rt. 3, Box 144 Lambert, Miss. (mailing address)	description of formations encountered	from	to
WELL LOCATION: sec. 19 T 27 N R 1 E 15E 4 miles East South of Lambert (distance) (direction) (nearest town)			
WELL PURPOSE: irrigation (home, irrigation, municipal, industrial)	Fine Sand	10	20'
WELL COMPLETION DATA: (1) diameter (inches) 16"	Coarse Sand	20	52'
(2) total depth (feet) 119'	Gravel & Coarse sand	52	82'
(3) static water level (feet) 9 below top of ground.	Gravel	82	119'
(4) casing Steel 59' (material) (depth) 16" if telescope see back. (size)			
(5) screen 60' 60' (length) (depth to top) 16" Steel (size) (material)			
(6) pump 60 2800-3000 (HP) (yield gpm) engine (type power)			
(7) electric log no (yes or no) (organization running log)			
(8) how well bottom plugged steel plate			
DRILLERS REMARKS:			

CODED

REGISTERED  
MAY 14 1975

If well telescopes please sketch and show depths.

GROUND LEVEL

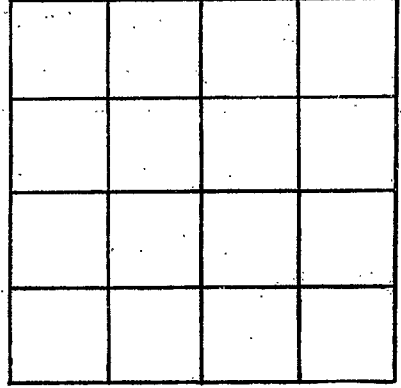

SECTION \_\_\_\_\_

Please indicate well location X.

ADDITIONAL INFORMATION

If more than one screen,  
show locations of each on sketch.