

Quitman
J 15
6-19-75

MISSISSIPPI
 BOARD OF WATER COMMISSIONERS
 416 North State Street
 Jackson, Mississippi 39201

WATER WELL DRILLERS CO. INC.


Singer-Rayne

CODED

June 19, 1975 Rufus Wright Quitman
 date well completed firm name county well located

LANDOWNER: <u>Rufus Wright</u> Rt. ³ / ₅ , Box 144 Lambert, Miss. (mailing address)	description of formations encountered	from	to
WELL LOCATION: sec. <u>19</u> T <u>27</u> N R <u>1</u> E <u>4</u> miles ^E / _S of <u>Lambert</u> (distance) (direction) (nearest town)			
WELL PURPOSE: <u>irrigation</u> (home, irrigation, municipal, industrial)	Fine Sand	18	22'
WELL COMPLETION DATA:	Clay & streak of sand	22	30'
(1) diameter (inches) <u>16"</u>	Coarse sand	30	82'
(2) total depth (feet) <u>115'</u>	Gravel & Coarse sand	82	115'
(3) static water level (feet) <u>10</u> ^{below} / _{top of ground}			
(4) casing <u>Steel</u> , <u>55'</u> (material) (depth) <u>16"</u> if telescope see back. (size)			
(5) screen <u>60'</u> , <u>60'</u> (length) (depth to top) <u>16"</u> , <u>Steel</u> (size) (material)			
(6) pump <u>60</u> <u>2800-3000</u> (HP) (yield gpm) <u>engine</u> (type power)			
(7) electric log <u>no</u> (yes or no) (organization running log)			
(8) how well bottom plugged <u>steel plate</u>			
DRILLERS REMARKS:			


CODED

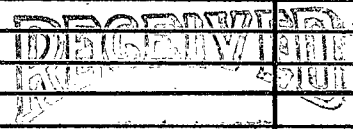

JUL 14 1975

If well telescopes please sketch and show depths.

GROUND LEVEL

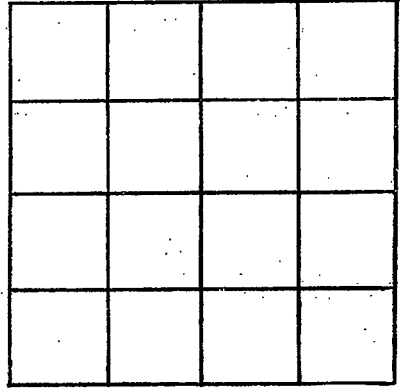

SECTION _____

Please indicate well location X.

ADDITIONAL INFORMATION

If more than one screen, show locations of each on sketch.