

QUITMAN
 J 49
 4/27/83

MISSISSIPPI DEPARTMENT OF NATURAL RESOURCES
 Bureau of Land and Water Resources
 Southport Mall
 P.O. Box 10631
 Jackson, Mississippi 39209
 WATER WELL DRILLERS LOG

CODED

4/27/83 19 Powell Irrigation Quitman
 date well completed firm name county well located

LANDOWNER: John Covington
Coffeeville Grain Elevator
Box 177, Coffeeville, MS 38922
 (mailing address)

description of formations encountered	from	to
Top soil	1	15
Coarse sand	15	40
Coarse sand & Gravel	40	95

WELL LOCATION:
 sec. 6 T 27 N R 1 E
 S W
3 miles SE of Marks
 (distance) (direction) (nearest town)

CODED

WELL PURPOSE: Irrigation
 (home, irrigation, municipal, industrial)

WELL COMPLETION DATA:

- (1) diameter (inches) 10
- (2) total depth (feet) 95
- (3) static water level (feet) 13 below above top of ground.
- (4) casing PVC, 45
 (material), (depth)
10 if telescope see back.
 (size)
- (5) screen 40, 55
 (length), (depth to top)
10, PVC
 (size), (material)
- (6) pump 10, 900
 (HP), (yield gpm)
Electric
 (type power)
- (7) electric log NO
 (yes or no)

(organization running log)

(8) how well bottom plugged Plastic Cap

DRILLERS REMARKS:


DEPT. OF NATURAL RESOURCES
 BUREAU OF LAND & WATER RESOURCES

MAY 20 1983

RECEIVED

If well telescopes please sketch and show depths.

GROUND LEVEL

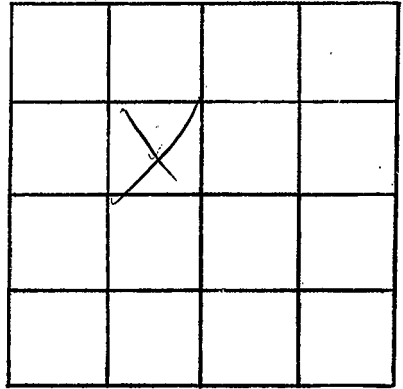

SECTION 6

Please indicate well location X.

ADDITIONAL INFORMATION

If more than one screen, show locations of each on sketch.