

MISSISSIPPI DEPARTMENT OF NATURAL RESOURCES

Bureau of Land and Water Resources

Southport Mall

P.O. Box 10631

Jackson, Mississippi 39209 CODED

WATER WELL DRILLERS LOG

Quitman
 50
 4/15/82

4-15-82 19
 date well completed

POWELL IRRIGATION
 firm name

Quitman
 county well located

LANDOWNER: W.L. TURNER

description of formations encountered

from

to

Batesville Miss
 (mailing address)

CLAY	0	13
FINE BROWN SAND	13	23
FAIR SAND	23	43
MED SAND	43	53
GRAVEL	53	103

WELL LOCATION:

sec. 4 T. 27 N. R. 1 E.
 S W
4 miles EAST of MARSH
 (distance) (direction) (nearest town)

WELL PURPOSE: IRRIGATION
 (home, irrigation, municipal, industrial)

WELL COMPLETION DATA:

- (1) diameter (inches) 12"
- (2) total depth (feet) 103
- (3) static water level (feet) 10' below above top of ground.
- (4) casing 12", 63'
 (material), (depth),
 (size) if telescope see back.
- (5) screen 40', 63'
 (length), (depth to top)
12", steel
 (size), (material)
- (6) pump 1/0, 2000
 (HP), (yield gpm)
Diesel
 (type power)
- (7) electric log NO
 (yes or no)

(organization running log)

(8) how well bottom plugged steel plate

DRILLERS REMARKS:


DEPT. OF NATURAL RESOURCES
 BUREAU OF LAND & WATER RESOURCES

JUN - 4 1982

RECEIVED

If well telescopes please sketch and show depths.

GROUND LEVEL

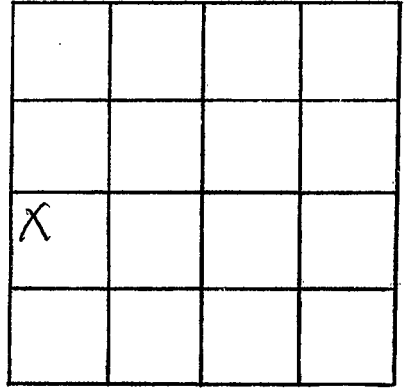

SECTION 4

Please indicate well location X.

ADDITIONAL INFORMATION

If more than one screen,
show locations of each on sketch.