

MISSISSIPPI DEPARTMENT OF NATURAL RESOURCES

Bureau of Land and Water Resources

Southport Mall

P.O. Box 10631

Jackson, Mississippi 39209 CODED

WATER WELL DRILLERS LOG

Quitman
J 57
10/9/82

10-9
 date well completed

1981 Dyer Well & Irrigation
 firm name

Quitman
 county well located

LANDOWNER: <u>Max Scheley</u>	description of formations encountered	from	to
<u>Lambert, Miss.</u> (mailing address)	<u>Clay</u> <u>fine sand</u> <u>Sand & gravel</u>	<u>0</u> <u>18</u> <u>30</u>	<u>18</u> <u>40</u> <u>103</u>
WELL LOCATION: sec. <u>23</u> T. <u>27</u> N. R. <u>10</u> E S W <u>3/2</u> miles <u>E</u> of <u>Lambert</u> (distance) (direction) (nearest town)			
WELL PURPOSE: <u>Irrigation</u> (home, irrigation, municipal, industrial)			
WELL COMPLETION DATA:			
(1) diameter (inches) <u>12"</u>			
(2) total depth (feet) <u>103</u>			
(3) static water level (feet) <u>21</u> below top of ground.			
(4) casing <u>Steel</u> , <u>63</u> (material) (depth) <u>12"</u> if telescope see back. (size)			
(5) screen <u>40</u> , <u>63</u> (length) (depth to top) <u>12"</u> , <u>Mild Steel</u> (size) (material)			
(6) pump <u>40</u> , <u>2000</u> (HP) (yield gpm) <u>Diesel</u> (type power)			
(7) electric log <u>No</u> (yes or no) <u>None</u> (organization running log)			
(8) how well bottom plugged <u>Plate</u>			
DRILLERS REMARKS:			


DEPT. OF NATURAL RESOURCES
 BUREAU OF LAND & WATER RESOURCES

SEP 30 1982

RECEIVED

If well telescopes please sketch and show depths.

GROUND LEVEL

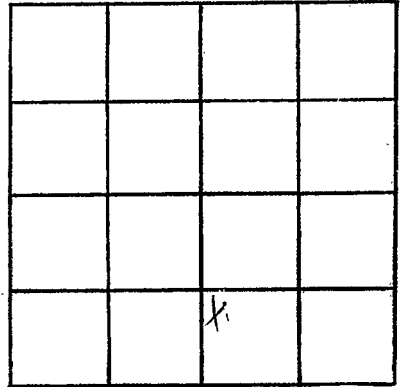

SECTION 33

Please indicate well location X.

ADDITIONAL INFORMATION

If more than one screen,
show locations of each on sketch.