

MISSISSIPPI DEPARTMENT OF NATURAL RESOURCES

Bureau of Land and Water Resources

Southport Mall

P.O. Box 10631

Jackson, Mississippi 39209

WATER WELL DRILLERS LOG

CODED

*Quitman*  
 J 52  
 10/15/82  
 15

10-15  
 date well completed

1981 DYER WELL & IRR  
 firm name

*Quitman*  
 county well located

LANDOWNER: <u>MAX SCHELEY</u>	description of formations encountered	from	to
<u>LAMBERT MISS.</u> (mailing address)	<u>Clay</u> <u>fine sand</u> <u>sand &amp; gravel</u>	<u>0</u> <u>18</u> <u>40</u>	<u>18</u> <u>40</u> <u>100</u>
<p>WELL LOCATION:</p> <p>sec. <u>33</u> T <u>27</u> N R. <u>1</u> E                  S W</p> <p><u>4</u> miles <u>E</u> of <u>Lambert</u>                  (distance) (direction) (nearest town)</p>			
<p>WELL PURPOSE: <u>IRRIGATION</u>                  (home, irrigation, municipal, industrial)</p>			
<p>WELL COMPLETION DATA:</p> <p>(1) diameter (inches) <u>12"</u></p> <p>(2) total depth (feet) <u>100</u></p> <p>(3) static water level (feet) <u>21</u> below                  top of ground.</p> <p>(4) casing <u>STEEL</u>, <u>60</u>,                  (material) (depth)  <u>12"</u>                  (size) if telescope see back.</p> <p>(5) screen <u>40</u>, <u>60</u>                  (length) (depth to top)  <u>12"</u>, <u>STEEL</u>                  (size) (material)</p> <p>(6) pump <u>40</u>, <u>2000</u>                  (HP) (yield gpm)  <u>DIESEL</u>                  (type power)</p> <p>(7) electric log <u>NO</u>                  (yes or no)  <u>NONE</u>                  (organization running log)</p> <p>(8) how well bottom plugged <u>Plate</u></p>			
<p>DRILLERS REMARKS:</p>			


DEPT. OF NATURAL RESOURCES  
 BUREAU OF LAND & WATER RESOURCES

SEP 30 1982

RECEIVED

If well telescopes please sketch and show depths.

GROUND LEVEL

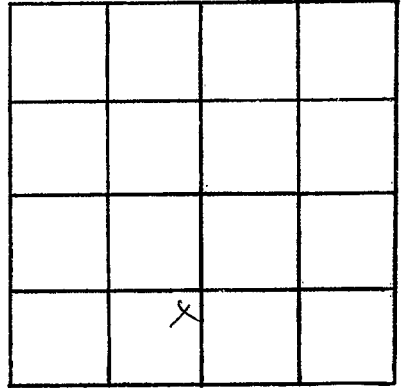

SECTION 33

Please indicate well location X.

ADDITIONAL INFORMATION

If more than one screen,  
show locations of each on sketch.