Part a never received County:	Por Office Use Only: Aquifer: Well #: L. S. Elevation: E-log #:			
State Law requires that this report be prepared by the driller in detail and filed with the Department within 30 days of completion of drilling of the well.				
Well Owner Information Owner Name John W, Crongows- Latitude: <u>54</u>	Well Location • 14 • X56" Longitude <u>90 • 13</u> • 133 " 51 t/Long (circle one): Conventional Survey,			
Brunton al 35216 NW 4 N	USGS quad, Hand-held GPS, Survey-grade GPS <u>N W 14 N W 14 Sec</u> <u>Twn I 7 W Rng</u> Distance <u>Direction</u> Nearest Town <u>Miles</u> <u>Wash</u> of <u>M MLKS</u>			
Well Data				
Purpose of Well (circle one) Home Industrial Public Supply Irrigation Fish Culture Other: Date well drilling started: 12-2-05 Date well drilling completed: If flowing, method of flow regulation: Valve Other (describe)				
Static Water Level: <u>N/A</u> feet above or below (circle one) land surface Date measured:				
State water Level. $\frac{1}{2}$ $\frac{1}{2}$ it could above of below (circle one) and barrier Method of Measurement (circle one) steel tape electric tape air line other: Hole depth: 120 100 100 feet				
Type of grout (circle one): Cement Bentonite Mix Casing length: 60 feet Casing diameter: 16 inches 5 Screen length: 10 feet Screen diameter: 16 inches 5 Screen slot size: 005 inches Setting depth: From 60	1			
Type of completion (circle all applicable): Gravel packed Underreamed Telescoped Open hole Natural Development				
Other (describe):				
Top of lap pipe or reduction in casing:feet. If telescoped or more than one screen, describe on back of page Logs run (circle all applicable): No log run Electric Gamma Ray Density Sonic Neutron Other:				
Name of organization running log(s):				
Department of Environmental Quality and/or the Mississippi Department of Health regulations and state laws.				
Print Name of Water Well Contractor and License No.	Signature of Water Well Contractor			


DEC 1 3 2005 BY: OLWR If well telescopes please sketch below and show depths.

J-65

Ground Level

Des	cription of Formations Encountered	From	То
	Joan Joil	0	45
	Sand & Course Part	45	60
	Course Sand + Big Roch	60	100
	0		
-			
	6		
· L			

If more than one screen, show location of each on sketch

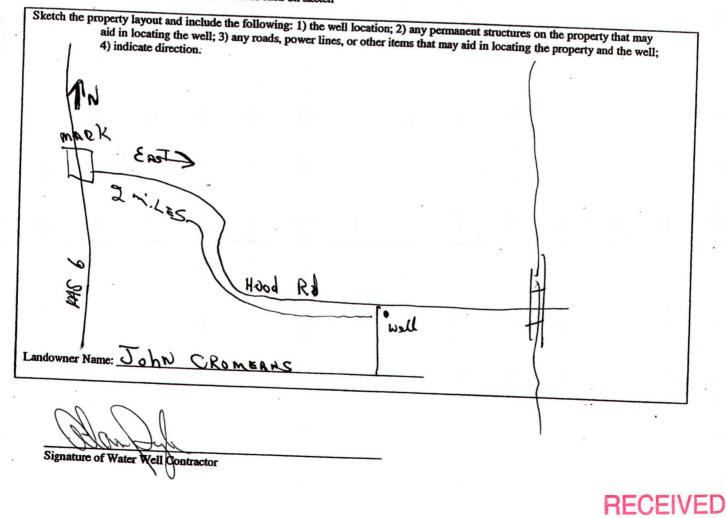

DEC 13 2005 BY: OLWR