

State Well Report

Part 1

Mississippi Department of Environmental Quality
Office of Land and Water Resources
P.O. Box 10631
Jackson, MS 39289-0631
(601)961-5210
(601)354-6938 (fax)

County: Quitman
Permit #: _____
Irrigation Equipment
Driller: _____
Date drilling completed: 6-16-06

For Office Use Only:

Aquifer: _____
Well #: J-66
L. S. Elevation: _____
E-log #: _____

State Law requires that this report be prepared by the driller in detail and filed with the Department within 30 days of completion of drilling of the well.

Well Owner Information	Well Location
Owner Name: <u>Doug Wiggs</u>	Latitude: <u>34.13 23.1</u> Longitude: <u>90 13 23.3</u>
Mailing Address: <u>250 Wiggs Road</u>	Method of Lat/Long (circle one): <u>23</u> Conventional Survey, <u>23</u>
<u>Marks, MS 38646</u>	USGS quad, Hand-held GPS, Survey-grade GPS
City: _____ State: _____ Zip Code: _____	<u>NE</u> ¼ <u>SE</u> ¼ Sec <u>7 8</u> Twn <u>27N</u> Rng <u>1E</u>
Telephone No. <u>662-526-4740</u>	<u>NW</u> <u>SW</u> Distance: <u>4</u> Miles Direction: <u>SE</u> of Nearest Town: <u>Marks</u>

Well Data

Purpose of Well (circle one) Home Industrial Public Supply Irrigation Fish Culture Other: _____
Date well drilling started: 6-16-06 Date well drilling completed: 6-16-06
If flowing, method of flow regulation: Valve _____ Other (describe) _____
Static Water Level: 17' feet above or below (circle one) land surface Date measured: 6-17-06
Method of Measurement (circle one) steel tape electric tape air line other: _____
Hole depth: 125 Well depth: 125 Well grouted to a depth of 10 feet
Type of grout (circle one): Cement Bentonite Mix
Casing length: 85 feet Casing diameter: 12 inches Type of casing: PVC
Screen length: 40 feet Screen diameter: 12 inches Type of screen: PVC
Screen slot size: .050 inches Setting depth: From 86 feet to 125 feet
Type of completion (circle all applicable): Gravel packed Underreamed Telescoped Open hole Natural Development
Other (describe): _____
Top of lap pipe or reduction in casing: _____ feet. If telescoped or more than one screen, describe on back of page
Logs run (circle all applicable): No log run Electric Gamma Ray Density Sonic Neutron Other: _____
Name of organization running log(s): _____

I certify that the well was drilled, constructed, and completed in accordance with all applicable requirements of the Mississippi Department of Environmental Quality and/or the Mississippi Department of Health regulations and state laws.

Irrigation Equipment Inc.
Patrick M. Chism 0695

Patrick M. Chism

Print Name of Water Well Contractor and License No.

Signature of Water Well Contractor

RECEIVED

JUL 10 2006

BY OLW

J-


If well telescopes please sketch below and show depths.

Ground Level

Description of Formations Encountered	From	To
Clay	0	18
Fine Sand	19	25
Fine Sand/gravel	26	50
Med. Sand/gravel	51	25

If more than one screen, show location of each on sketch

Sketch the property layout and include the following: 1) the well location; 2) any permanent structures on the property that may aid in locating the well; 3) any roads, power lines, or other items that may aid in locating the property and the well; 4) indicate direction.

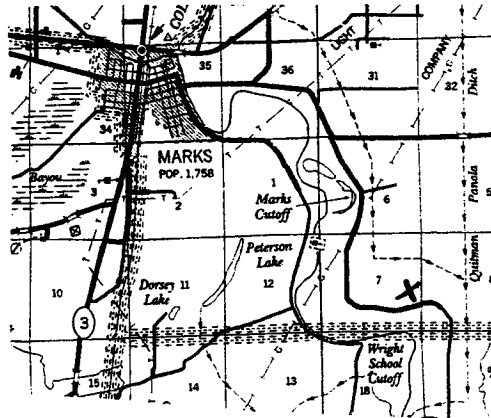

Landowner Name: _____

Patrick M. Chen

 Signature of Water Well Contractor

STATE WELL REPORT

Part 2

Pump Installer's Completion Report
Mississippi Department of Environmental Quality
Office of Land and Water Resources
P.O. Box 10631
Jackson, MS 39289-0631
(601)961-5210
(601)354-6938 (fax)

County: Quitman
Permit #: _____
Irrigation Equipment
Driller: _____
Date completed: 6-16-06
Copy information from block on Part 1

For Office Use Only:
Aquifer: _____
Well #: J-66
Elevation: _____

This part of the report must be completed by a licensed water well contractor or a licensed pump installer. A copy of Part 1 of the report must be attached and both parts filed with the Department at the above address within 30 days of well completion.

Well Owner Information	Well Location
Owner Name: <u>Doug Wiggs</u>	Latitude: _____ Longitude: _____
Mailing Address: <u>250 Wiggs Road</u>	Method of Lat/Long (check one): Conventional Survey _____ USGS quad _____, Hand-held GPS _____, Survey-grade GPS _____
<u>Marks, MS 38646</u>	<u>NE 1/4 SE 1/4 Sec 7 T 27 N R 1 E</u>
City State Zip Code	Distance Direction Nearest Town
<u>662-526-4740</u>	<u>4 Miles se of Marks</u>
Telephone No. () _____	

Pump Type Circle one	Power Type Circle one
Air Lift Jet Submersible	<u>Diesel Engine</u> Gasoline Engine Natural Gas
Bucket Piston <u>Turbine</u>	Electric Motor Hand Tractor PTO
Centrifugal Rotary Flowing Well	Windmill Other (specify): _____
Other (specify): _____	Horse Power Rating of Motor: <u>30</u>
Date Pump Installed: <u>6-17-06</u>	Setting Depth: <u>50</u> feet
Rated Pump Capacity: <u>1400</u> Gallons Per Minute	Number of Stages: <u>2</u>

Pump Test Data	Method of Measuring Water Level Circle one
Date Well Tested: _____	Air Line Electric Measuring Line Steel Tape
Static Water Level (A): _____ Feet Below Land Surface	Other (specify): _____
Pumping Water Level (B): _____ Feet Below Land Surface	For flowing well, measured shut in head: _____ feet
Drawdown [(B) - (A)]: _____ Feet Below Land Surface	Well yielded _____ GPM with a drawdown of _____ feet after _____ hours of pumping
Test Pumping Rate: _____ Gallons Per Minute	
Duration of Pump Test (minimum 4 hours): _____ hours	

I HEREBY CERTIFY that the above statements are true to the best of my knowledge.

Patrick M. Chism 0695
Print Name of Pump Installer and License No. (if applicable)

Patrick M. Chism
Signature of Pump Installer

Form OLWR SWR-10
RECEIVED

JUL 10 2006

BY: OLWR