
| | State W | ell Report | r om the orbin | |
|--|----------------------------------|----------------------------------|---|--|
| County: Quitman | | Priller's Log | For Office Use Only: | |
| | | nt of Environmental Quality | Aquifer: | |
| Permit #: <u>GW-49540</u> | | nd Water Resources Box 2309 | Well#: 596 | |
| Driller: Joel Jumper | | n, MS 39225 | L. S. Elevation: | |
| Date drilling completed: 6-17-16 | • • | 961- 5210 4 - 5339 (faul) | E. S. GICYALION. | |
| | (601)96 | 1- 5228 (fax) | E-log #: | |
| State Law requires that this report | be prepared by the lic | ense holder responsible for t | he work and filed with the | |
| Department at the above address | within 30 days of comp | letion of drilling of the well | or borehole. | |
| Information on Well O (Landowner if borehole is not fo | | | | |
| Owner Name Cromeons Property LLC | | Latitude: 34 ° 14 '65 | " Longitude: 90° 13 · 7 " | |
| | • • | Method of Lat/Long (circle on | e): Conventional Survey, | |
| Mailing Address: 2104 Ho | 2104 Harris. | | USGS quad, Hand-held GPS Survey-grade GPS | |
| Drive | | | | |
| Oxford 11= 38/055 | | SE 1/2 NUV Sec OS | Twn 27N Rng OLE | |
| Oxtora Ms 38055 City State Zip Code | | Distance Direction | Nearest Town | |
| | | A Miles 5E | of Mark) | |
| Telephone No. () | ······ | | | |
| Well / Borchole Data | | | | |
| Date drilling started: (a-17-16) Date drilling completed: (a-17-16) Hole depth: 103 Hole diameter: 28 in | | | | |
| Location of the source of any surface water | used for drilling: | leavest (No | 211 | |
| Method of dosing and volume of Chlorine | used in drilling and devel | opment: | | |
| Logs run (circle all applicable): No log run Name of organization running log(s): | Electric Gamma Ray | Density Sonic Neutron (| Other: | |
| Purpose of borehole (check one): Water We | II Geotechnical/Geok | gical Investigation Ground | Source Heat Pump | |
| Seismic S | urveyOther (describe) | | | |
| If drilling is not related t | <u>o water well construction</u> | , skip the remainder of this blo | <u>ck</u> | |
| Purpose of Well (check one): HomeInc | dustrialPublic Supply | Irrigation Fish Culture_ | Other: | |
| If a flowing well, method of flow regulation: Valve Other (describe) | | | | |
| Static Water Level: 6 feet above or below (circle one) land surface Date measured: 6-17-16 | | | | |
| Method of Measurement (circle one) steel tape electric tape air line other: | | | | |
| Well depth: 103 Well grouted to a dept | th of 10 feet Type | of grout (circle one): Neat Ceme | nt Bentonite Mix | |
| Casing length: 63 feet Casing diameter: 16 inches Type of casing: DUC | | | | |
| Screen length: 40 feet Screen diameter: 10 inches Type of screen: 900 | | | | |
| Screen slot size: O,50 inches | Setting depth: From | feet to | feet | |
| Type of completion (circle all applicable): Gravel packed Underreamed Telescoped Open hole Natural Development | | | | |
| Other (describe): | | | | |
| Fop of lap pipe or reduction in casing: feet. If telescoped or more than one screen, describe on next page | | | | |
| | | | Form: OLWR-SWR-1A (04/08) | |

Received

IJUL **07** 2013

The sketch below only required for water wells

If well telescopes, show depths on sketch.

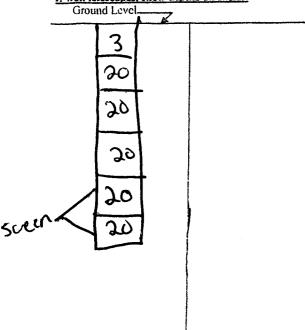

Description of formations encountered must be provided for all wells and boreholes, unless specifically exempted by regulations

| Description of Formations Encountered | From (depth) | To (depth) |
|---------------------------------------|--------------|------------|
| Gumbo | Ground Level | 90 |
| Sand | 30 | 40 |
| Eourse Sarel | 40 | (sc) |
| Course, sand | 60 | 80 |
| greet. | 80 | 100 |
| Excell | 100 | 103 |
| 3 | | |
| | | |
| | | |
| | ļ | ļ |
| | | ļ |
| | | |
| | | |
| | | |

If more than one screen, show location of each on sketch

| Sketch the property larout and include the following 1) the well location; 2) any perman | ers structures on the property that may |
|--|--|
| aid in locating the well; 3) any roads, power lines, or other items that may a | id in locating the property and the well: |
| 4) a north arrow. | 1 |
| will] & | Hay |
| | 1'2' |
| Hobd rd | 1 |
| Hobo | i |
| | |
| Itor ad | |
| Too a | Marks |
| • | |
| | Huy Ce |
| | |
| | |
| h | |
| Huyb | |
| 1 | |
| | |
| | \ \ \ \ \ \ \ \ \ \ \ \ \ \ \ \ \ \ \ |
| | 1 |
| | 1 1/ |
| Landowner Name: Cromean's Property LLC | <i>)</i> • |
| Landowner (value) | |
| | Form: OL WR-SWR-1A (04/08) |

I certify that the well/borehole was drilled, constructed, and completed in accordance with all applicable requirements of the Mississippi Department of Environmental Quality and the Mississippi Department of Health regulations, if applicable, and state

Soel Jumper 5317

Print Name of Responsible Licensee and License No.

1-11-10

Date

Signature of Licensee

Received

JUL 07 2016

By OLWR

STATE WELL REPORT

County: Permit #: Date completed: Copy information from block on Part 1

Part 2

Pump Installer's Completion Report Mississippi Department of Environmental Quality Office of Land and Water Resources

P.O. Box 2309 Jackson, MS 39225-2309 (601)961-5210 (601) 360-0535 (fax)

| For Office Use Only: |
|----------------------|
| Well #: |
| Aquifer: |

| This part of the report must be completed by a licensed water well contractor or a licensed pump installer. A copy of Part 1 of the report must be altached and both parts filed with the Department at the above address within 30 days of well completion. | | | | | |
|--|--|--|--|--|--|
| Well Owner Information Well Location | | | | | |
| Owner Name: Comeans Danerty LLC Latitude: 34-14-25 Longitude: 90-13-7 | | | | | |
| Mailing Address: 2104 Harris Method of Lat/Long (check one): Conventional Survey, | | | | | |
| USGS quad, Hand-held GPS, Survey-grade GPS | | | | | |
| OXTAGE MS 38655 SE 14 NW4, Sec 05 T 27N R OIE | | | | | |
| | | | | | |
| Telephone No. () State Zip Code Ailes SE of (Direction) (Nearest Town) | | | | | |
| Pump Type (circle one) | | | | | |
| Submersible Turbine Air Lift Centrifugal Flowing Well Jet Piston Rotary Other (describe): | | | | | |
| Date Pump Installed: 6-17-10 Rated Pump Capacity: 3, 000 Gallons Per Minute | | | | | |
| Is This Pump (circle one): New Repaired Replacement | | | | | |
| Power Type (circle one) | | | | | |
| Electric Diesel Gasoline Natural Gas Tractor PTO Windmill Other (describe): | | | | | |
| Horse Power Rating of Motor: 60 Setting Depth: 50 feet Number of Stages: | | | | | |
| Pump Test Data for Non Flowing Well | | | | | |
| Date Well Tested: 6-17-16 Duration of Pump Test (minimum 4 hours): hours | | | | | |
| Static Water Level (A): Feet Below Land Surface Pumping Water Level (B): Feet Below Land Surface | | | | | |
| Drawdown [(B) - (A)]: | | | | | |
| Method of measurement (circle one): Steel tape Electric tape Air line Other (describe): | | | | | |
| Pump Test Data for Flowing Well | | | | | |
| Measured shut in head:feet. | | | | | |
| Well yielded 3,000 GPM with a drawdown of 28 feet after hours of pumping | | | | | |
| Meter Installation | | | | | |
| i i | | | | | |
| Meter Manufacturer: Meter Serial Number: | | | | | |
| Meter Manufacturer: Meter Serial Number: Meter Model Number/Name: Type of Meter: | | | | | |
| We for indicators at | | | | | |
| Meter Model Number/Name: Type of Meter: | | | | | |
| Meter Model Number/Name: Type of Meter: Totalizer Register Unit and Multiplier Factor (AF x .001, gal x 1000, etc): | | | | | |

I HEREBY CERTIFY that the above statements are true to the best of my knowledge. Signature of Pump Installer Form: OLWR-SWR-18 (4/13)

JUL 07 2016