

Quitman
 J 2001
 11-2-76

MISSISSIPPI
 BOARD OF WATER COMMISSIONERS
 416 North State Street
 Jackson, Mississippi 39201

WATER WELL DRILLERS LOG

11-2 1976 North Miss Well Drilling Co. Quitman
 date well completed firm name county well located

LANDOWNER: Jerry Snyder
 Crowder

description of formations encountered	from	to
Clay sand	0	60
Gravel	60	130
Clay & Rock	130	290
sand	290	535

(mailing address)

WELL LOCATION:

sec. 25 T 27 N R 1 E
 S W
 1/4 miles 8 N of Crowder
 (distance) (direction) (nearest town)

WELL PURPOSE: Home
 (home, irrigation, municipal, industrial)

WELL COMPLETION DATA:



- (1) diameter (inches) 4 X 2
- (2) total depth (feet) 535
- (3) static water level (feet) 12 below above top of ground.
- (4) casing Plastic 535
 (material) (depth)
 4x2 if telescope see back.
 (size)
- (5) screen 40'
 (length) (depth to top)
 3" Slot Plastic
 (size) (material)
- (6) pump 15
 (HP) (yield gpm)
- (type power)
- (7) electric log NO
 (yes or no)
- (organization running log)
- (8) how well bottom plugged Plug

DRILLERS REMARKS:

RECEIVED
 DEC 21 1976
 MISS. BD. OF WATER COMMISSIONERS

If well telescopes please sketch and show depths.

GROUND LEVEL

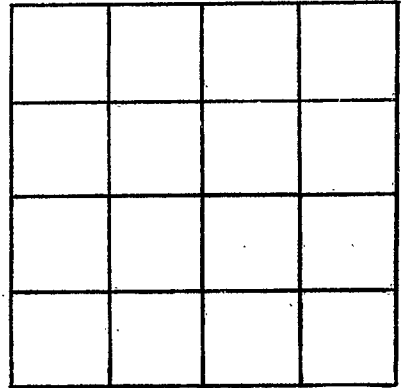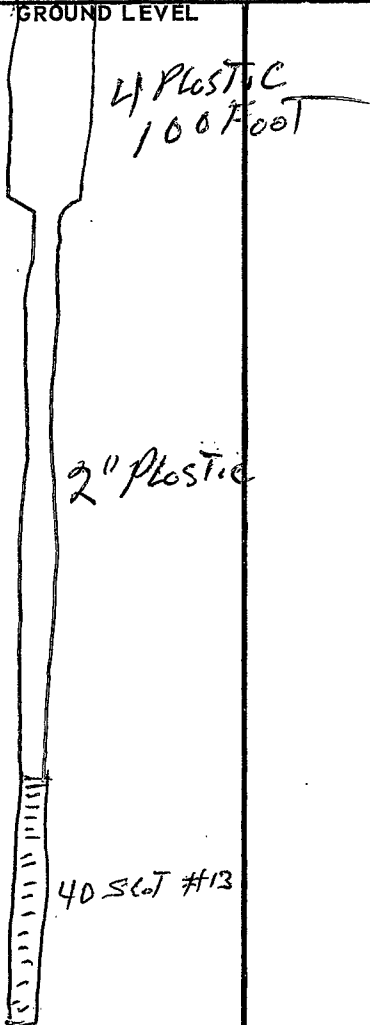

SECTION _____

Please indicate well location X.

ADDITIONAL INFORMATION

If more than one screen, show locations of each on sketch.