

Quitman  
 J 2002  
 9-19-77

MISSISSIPPI  
 BOARD OF WATER COMMISSIONERS  
 416 North State Street  
 15F Jackson, Mississippi 39201

WATER WELL DRILLERS LOG

9-19-77 date well completed  
 19 North Miss Well Drilling firm name  
 Quitman county well located


LANDOWNER	description of formations encountered	from	to
E. H. E. L. Sander			
RT 1 Crowder	Gumbo	0	12
Miss 38606 (mailing address)	Sand	12	105
WELL LOCATION: sec 27 T 29 N R 1 E	Sand and Clay	105	250
# 2 1/2 miles SW of Crowder (distance) (direction) (nearest town)	Rock streaks	250	265
WELL PURPOSE: Home (home, irrigation, municipal, industrial)	Sand and Clay	265	445
WELL COMPLETION DATA:	SAND	445	570
(1) diameter (inches) 4x2			
(2) total depth (feet) 570			
(3) static water level (feet) Flow below top of ground.			
(4) casing Plastic 570 (material) (depth)			
4x2 if telescope see back. (size)			
(5) screen 40' 470 (length) (depth to top)			
2" Plastic (size) (material)			
(6) pump NO 15 (HP) (yield gpm)			
(type power)			
(7) electric log NO (yes or no)			
(organization running log)			
(8) how well bottom plugged Plug			
DRILLERS REMARKS:			

RECEIVED  
 SEP 20 1977


MISS. BR. OF WATER COMMISSIONERS

If well telescopes please sketch and show depths.

GROUND LEVEL

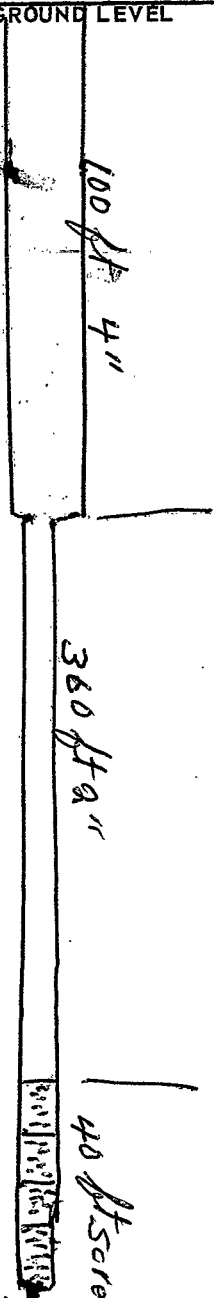

If more than one screen, show locations of each on sketch.

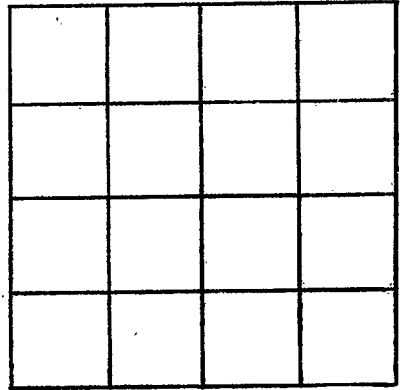

SECTION \_\_\_\_\_

Please indicate well location X.

ADDITIONAL INFORMATION

A series of horizontal lines for providing additional information.