

Quitman
J 2003
2/19/79

MISSISSIPPI
 BOARD OF WATER COMMISSIONERS
 416 North State Street
 Jackson, Mississippi 39201

WATER WELL DRILLERS LOG

2/19 1979 Lipe Well Co. Quitman
 date well completed firm name county well located

LANDOWNER:	description of formations encountered	from	to
<u>C.S. L. Batesville MS.</u>	<u>TOP soil</u>	<u>0</u>	<u>20</u>
	<u>sand and gravel</u>	<u>20</u>	<u>40</u>
	<u>sand</u>	<u>40</u>	<u>73</u>

(mailing address)
 WELL LOCATION:
 sec. 29 T 27 N R 1 E
S W
3 miles East of Lambert
 (distance) (direction) (nearest town)

WELL PURPOSE:
 (home, irrigation, municipal, industrial)

- WELL COMPLETION DATA:
- (1) diameter (inches) 4
 - (2) total depth (feet) 73
 - (3) static water level (feet) 10 below above top of ground.
 - (4) casing PVC 63
 (material) (depth)
4 If telescope see back.
 (size)
 - (5) screen 10 63
 (length) (depth to top)
4 PVC
 (size) (material)
 - (6) pump 3/4 10
 (HP) (yield gpm)
elec
 (type power)
 - (7) electric log no
 (yes or no)
no
 (organization running log)
 - (8) how well bottom plugged PVC
PIUB

DRILLERS REMARKS:


Miss. Board of Water Comm.

APR 1 - 1979

RECEIVED

If well telescopes please sketch and show depths.

GROUND LEVEL

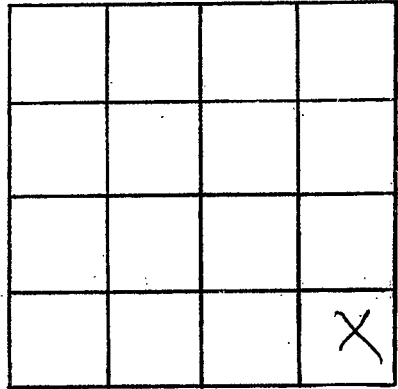

SECTION 29

Please indicate well location X.

ADDITIONAL INFORMATION

If more than one screen, show locations of each on sketch.