

QUIT MAN MISSISSIPPI BOARD OF WATER COMMISSIONERS


J

3-1-66

WATER WELL DRILLERS LOG

Date: Marchst, 1966, Driller: Luther Raliff County Leflore
 (Name)

	Description & Color of Materials Sand, Clay, Red Clay, Shell, etc.	Thick- ness Feet	Depth Feet
(1) Owner of Land: <u>Mr. Mills</u> (Name) <u>Crowder, Miss</u> (Address)	Clay & sand	0	35
(2) Location: <u>1/4</u> , <u>1/4</u> , Sec. <u>T</u> <u>R</u>	Sand	25	47
_____ miles _____, of _____ (distance) (direction) (Nearest Town)	gravel	47	69
(3) Topography: _____ (Hilly) (Flat) (Level)	gravel	69	113
(4) Purpose of Well: <u>Domestic</u> (Domestic Irrigation Municipal, Industrial, Other)	gravel & sand	113	135
Information upon completion of well:	Sand & clay	135	159
(1) Diameter <u>2</u> inches.	Clay & sand	159	179
(2) Total Depth <u>747</u> feet.	Clay	179	311
(3) Water Level <u>27</u> feet below top of ground.	Clay & shale	311	333
(4) Cased to <u>all the way</u> , Size <u>2</u> "	Clay	333	378
(5) Screen: Size <u>2</u> " , Length <u>20</u> '	sand & shale	378	399
(6) Were any formations sealed against pollution? _____ yes, <u>no</u> no.	shale	399	443
If YES depth of formation _____	shale & sand	443	509
Why _____	sand	509	597
Drillers Remarks: <u>Good water</u>	sand & shale	597	641
	sand	641	705
	clay	705	747

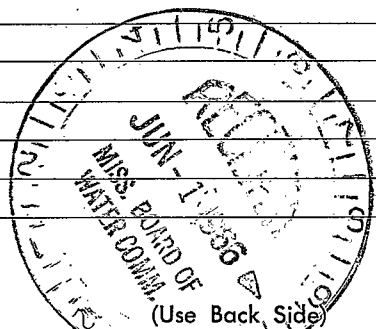

Well No.

