

MISSISSIPPI BOARD OF WATER COMMISSIONERS

QUITMAN
K 29
6-21-61

WATER WELL DRILLERS LOG

K 300
CODED

Date: 6/21, 1961, Driller: Five County Tractor Co. & Drilling
(Name)

(1) Owner of Land: W.M. Younfall Sr.
(Name)
Vance, Miss
(Address)
(2) Location: SW 1/4, SE 1/4, Sec 24, T26, R20
3 miles NW of Vance
(distance) (direction) (Nearest Town)
(3) Topography: Level
(Hilly) (Flat) (Level)
(4) Purpose of Well: irrigation
(Domestic Irrigation, Municipal, Industrial, Other)

Description & Color of Materials Sand, Clay, Red Clay, Shell, etc.	Thick- ness Feet	Depth Feet
<u>Clay, Silt, clay</u>	<u>10</u>	<u>10</u>
<u>clay</u>	<u>32</u>	<u>42</u>
<u>fine sand</u>	<u>6</u>	<u>48</u>
<u>barren sand, P shell</u>	<u>47</u>	<u>95</u>


Information upon completion of well:

(1) Diameter 6 inches.
(2) Total Depth 95 feet.
(3) Water Level 15 feet below top of ground.
(4) Cased to 42, Size 6"
(5) Screen: Size 6", Length 53
(6) Were any formations sealed against pollution?
_____ yes, ✓ no.

CODED

If YES depth of formation _____
Why _____

Drillers' Remarks: This well designed for irrigation

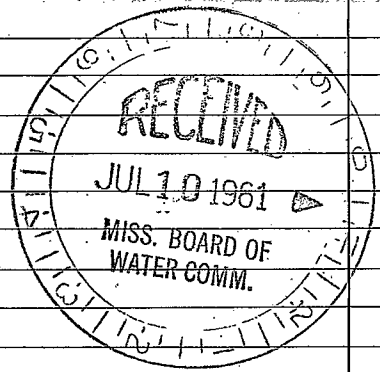

(Use Back Side)

Well No.

