

MISSISSIPPI
BOARD OF WATER COMMISSIONERS
416 North State Street
Jackson, Mississippi 39201

CODED
CODED

WATER WELL DRILLERS LOG

Quitman
R 31

7-18-69 date well completed Fair County Farmers Assn firm name Quitman county well located

LANDOWNER: Jandell Bus

Vance Miss
(mailing address)

description of formations encountered

from to

<u>Topsoil</u>		<u>10</u>	<u>10</u>
<u>Sand</u>		<u>10</u>	<u>29</u>
<u>Yellow Clay</u>		<u>29</u>	<u>42</u>
<u>Coarse Sand + Gravel</u>		<u>42</u>	<u>117</u>
<u>Vance Rocks Clay</u>			<u>117</u>

WELL LOCATION:

sec 25 T 26 N R 2 W
1 1/2 miles N of Vance
(distance) (direction) (nearest town)

WELL PURPOSE: Irrigation
(home, irrigation, municipal, industrial)

WELL COMPLETION DATA:

- diameter (inches) 6
- total depth (feet) 117
- static water level (feet) 15 below above top of ground.
- casing Pipe, 69
(material) (depth)
6 if telescope see back.
(size)
- screen 48, 69
(length) (depth to top)
6, Open top
(size) (material)
- pump 40, 1450
(HP) (yield gpm)
Chrysler
(type power)
- electric log NO
(yes or no)

(organization running log)

(8) how well bottom plugged welded

DRILLERS REMARKS:


CODED

JUL 28 1969

MISS. BD. OF
WATER COMMISSIONERS

If well telescopes please sketch and show depths.

GROUND LEVEL

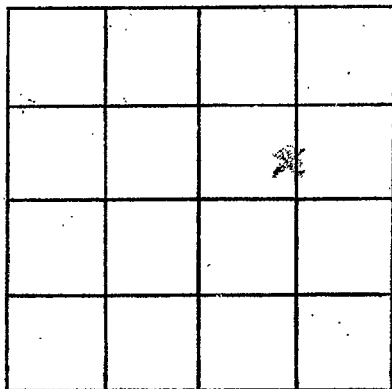

SECTION 25

Please indicate well location X.

ADDITIONAL INFORMATION

If more than one screen,
show locations of each on sketch.