

Quintman
K35

MISSISSIPPI
BOARD OF WATER COMMISSIONERS
416 North State Street
Jackson, Mississippi 39201

CODED

WATER WELL DRILLERS LOG

2-20-1970 date well completed Delta Well Drilling firm name Quintman county well located

LANDOWNER: Thomas H. Smith
R.F.D. 1 Box 93
Osage Miss 38930
(mailing address)

WELL LOCATION:
sec. 33 T26 N R. 3 E
4 miles North of Tutwiler
(distance) (direction) (nearest town)

WELL PURPOSE: None
(home, irrigation, municipal, industrial)

- WELL COMPLETION DATA:
- (1) diameter (inches) 4 1/2"
 - (2) total depth (feet) 903
 - (3) static water level (feet) 5 below top of ground.
 - (4) casing Galv. 803
(material) (depth)
 - 40 if telescope see back.
(size)
 - (5) screen 20
(length) (depth to top)
5" 5/16" stainless
(size) (material)
 - (6) pump 1 30
(HP) (yield gpm)
Ele
(type power)
 - (7) electric log NO
(yes or no)

(organization running log)

(8) how well bottom plugged Spud

DRILLERS REMARKS:
[Signature]

description of formations encountered	from	to
CLAY	0	16
SAND + GRAVEL	16	167
CLAY	162	166
SAND + SHALE SLICK	166	305
Hard shale	305	320
Sandy shale	320	365
SAND	365	406
SHALE	406	466
SAND	466	533
" SHALE SLICK	533	570
ROCK	570	571
SHALE	571	630
ROCK	630	630 1/2
SAND	630 1/2	641
ROCK	641	642
SAND	642	648
ROCK	648	649
Runny shale	649	673
ROCK	673	674
SAND	674	688
ROCK	688	689
Hard shale	689	732
SAND	732	760
Hard shale	760	770
SAND	770	915


CODED

JUN 12 1970

MISS. BD. OF
WATER COMM.

If well telescopes please sketch and show depths.

GROUND LEVEL

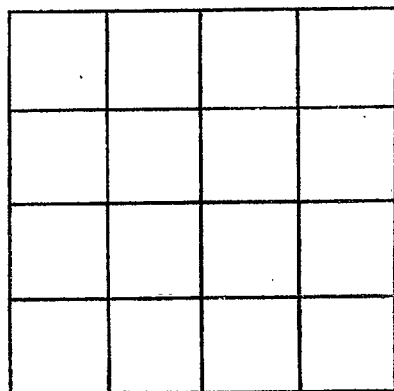

SECTION _____

Please indicate well location X.

ADDITIONAL INFORMATION

If more than one screen,
show locations of each on sketch.