

Quitman
K37

MISSISSIPPI BOARD OF WATER COMMISSIONERS

7-66

WATER WELL DRILLERS LOG

CODED

Date: 7.21, 1966, Driller: John C. Jones ^(Name) County: Quitman

(1) Owner of Land: J.W. Henderson
(Name)
Clark's Old Mine
403 Cypress (Address)

(2) Location: SW 1/4, NE 1/4, Sec. 7 ^{26 2} T. N R. W
1/2 miles SE (direction), of Delaware (Nearest Town)

(3) Topography: flat
(Hilly) (Flat) (Level)

(4) Purpose of Well: irrigation
(Domestic, Irrigation, Municipal, Industrial, Other)

Description & Color of Materials Sand, Clay, Red Clay, Shell, etc.	Thick- ness Feet	Depth Feet
<u>Clay (Beekmantown)</u>	<u>40</u>	<u>40</u>
<u>Fine trace of clay</u>	<u>19 1/2</u>	<u>59 1/2</u>
<u>Sand (Coarse)</u>	<u>19 1/2</u>	<u>79</u>
<u>Sand & coarse gravel</u>	<u>59</u>	<u>138</u>

Information upon completion of well:

(1) Diameter 6 inches.

(2) Total Depth 138 feet.

(3) Water Level 15 feet below top of ground.

(4) Cased to 76, Size 6

(5) Screen: Size 6, Length 48


(6) Were any formations sealed against pollution?
 yes, no.

CODED

If YES depth of formation _____

Why _____

Drillers Remarks: _____

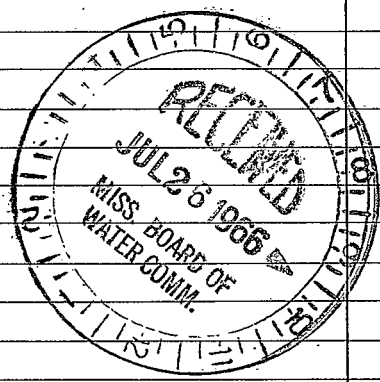

(Use Back Side)

Well No.

