

Quitman  
K38  
9-67

MISSISSIPPI  
BOARD OF WATER COMMISSIONERS  
416 North State Street  
Jackson, Mississippi 39201

**CODED**

WATER WELL DRILLERS LOG

Quitman

Sept 8 1967 date well completed  
Fife County Farmers Ass. firm name  
Quitman county well located

LANDOWNER: ~~MARK HAM - Joe~~  
Tom Harris  
Lyon Miss  
(mailing address)


| description of formations encountered | from | to     |
|---------------------------------------|------|--------|
| TOPSOIL                               |      | 14     |
| FINE SAND                             |      | 46 1/2 |
| MED SAND                              |      | 57 1/2 |
| COARSE SAND                           |      | 72 1/2 |
| FINE SAND                             |      | 79     |
| Fine sand + streaks of clay           |      | 88     |
| Gravel + Sand                         |      | 111    |
| SOLID Rock                            |      |        |

WELL LOCATION:  
sec. 20 T 21 N R 8 E  
SW  
10 miles SW of Salina  
(distance) (direction) (nearest town)

WELL PURPOSE:  
(home, irrigation, municipal, industrial)

- WELL COMPLETION DATA:
- (1) diameter (inches) 6"
  - (2) total depth (feet) 105.8
  - (3) static water level (feet) 15 below top of ground.
  - (4) casing Pipe (material), 57'8" (depth)  
6 (size) if telescope see back.
  - (5) screen 48 (length), 57'8" (depth to top)  
6 (size), Dorn 101 (material)
  - (6) pump 30 (HP), (yield gpm)  
Incher (type power)
  - (7) electric log (yes or no)
  - (organization running log)
  - (8) how well bottom plugged welded

**CODED**

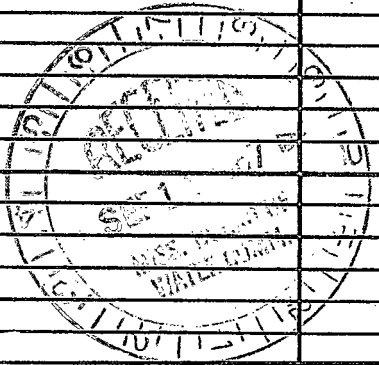


DRILLERS REMARKS:  
RW

*[Handwritten signature]*

If well telescopes please sketch and show depths.

GROUND LEVEL

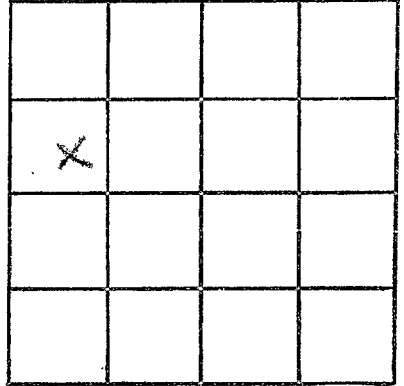

SECTION 30

Please indicate well location X.

ADDITIONAL INFORMATION

If more than one screen, show locations of each on sketch.