

QUITMAN
K39
10-5-73

MISSISSIPPI
 BOARD OF WATER COMMISSIONERS
 416 North State Street
 Jackson, Mississippi 39201

CODED

WATER WELL DRILLERS LOG

Oct. 5 19 73 Five County Farmers Assn Quitman
 date well completed firm name county well located

LANDOWNER: Otis Meredith
RFD Marks Miss
 (mailing address)

description of formations encountered	from	to
<u>Clay</u>	<u>0</u>	<u>44.5</u>
<u>Sand</u>	<u>44.5</u>	<u>51</u>
<u>Sand & Gravel</u>	<u>51</u>	<u>110.5</u>

WELL LOCATION:
 sec. 15 T. 26 (N) R. 2 E (W)
1/2 miles South of Sebino
 (distance) (direction) (nearest town)

WELL PURPOSE: Irrigation
 (home, irrigation, municipal, industrial)

WELL COMPLETION DATA:

(1) diameter (inches) 6"

(2) total depth (feet) 110.5

(3) static water level (feet) 12 (below/above top of ground)

(4) casing Black Pipe, 62.5
 (material) (depth)
6" if telescope see back.
 (size)

(5) screen 48, 62.5
 (length) (depth to top)
6", Louvre
 (size) (material)

(6) pump 240 Haws 800
 (HP) (yield gpm)
Tractor
 (type power)

(7) electric log No
 (yes or no)

(organization running log)

(8) how well bottom plugged Welded


CODED

DRILLERS REMARKS:

OCT 30 1973
 MISS. Bd. of
 WATER COM.

If well telescopes please sketch and show depths.

GROUND LEVEL

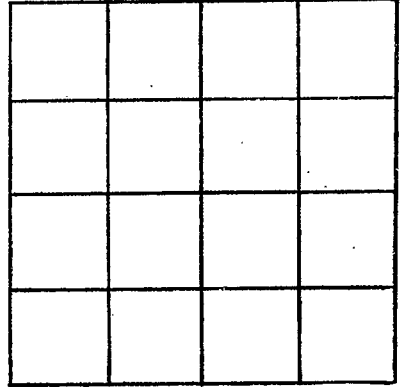

SECTION _____

Please indicate well location X.

ADDITIONAL INFORMATION

A series of horizontal lines providing space for additional information.

If more than one screen, show locations of each on sketch.