

**MISSISSIPPI
BOARD OF WATER COMMISSIONERS**
416 North State Street
Jackson, Mississippi 39201

WATER WELL DRILLERS LOG

CODED

Quitman
K 40
6-16-75

6/16/75 1975 FIVE COUNTY FARMERS ASSN QUITMAN
date well completed firm name county well located

LANDOWNER: R. A. CARSON
1/2 BUCKSKIN PLANTATION
LANBERT, MISS.
(mailing address)

description of formations encountered	from	to
<u>CLAY TOPSOIL</u>	<u>0</u>	<u>18</u>
<u>SAND</u>	<u>18</u>	<u>48</u>
<u>SAND - GRAVEL</u>	<u>48</u>	<u>116</u>

WELL LOCATION:
sec. 2 T 26 N R 2 E 15F.
S W
3 miles WEST of BELLEVUE
(distance) (direction) (nearest town)

WELL PURPOSE:
(home, irrigation, municipal, industrial)

- WELL COMPLETION DATA:
- diameter (inches) 6"
 - total depth (feet) 116'
 - static water level (feet) 12' below top of ground. above
 - casing BLACK PIPE, 68'
(material) (depth)
6" if telescope see back.
(size)
 - screen 48' 68'
(length) (depth to top)
6" BLACK DOZER
(size) (material)
 - pump 40 1750
(HP) (yield gpm)
POWER UNIT
(type power)
 - electric log No
(yes or no)
(organization running log)
 - how well bottom plugged WELDED


CODED

REGISTERED
JUN 20 1975
MISS. BD. OF WATER COMMISSION

DRILLERS REMARKS:

If well telescopes please sketch and show depths.

GROUND LEVEL

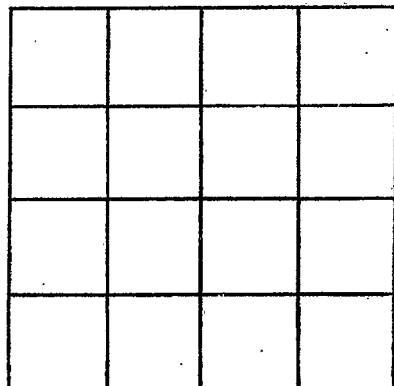

SECTION _____

Please indicate well location X.

ADDITIONAL INFORMATION

If more than one screen, show locations of each on sketch.