

Quitman  
K 41  
9-10-75

MISSISSIPPI  
 BOARD OF WATER COMMISSIONERS  
 416 North State Street  
 Jackson, Mississippi 39201

**CODED**

WATER WELL DRILLERS LOG

9/10 1975 FIVE COUNTY FARMERS ASSN. QUITMAN  
 date well completed firm name county well located

LANDOWNER: WALNUT GIN Co.

Rt. 1

VANCE, Miss.

(mailing address)

WELL LOCATION:

sec. 18 T 26 (N) S R 2 (E) (W) 15F  
1/8 miles EAST of WALNUT  
 (distance) (direction) (nearest town)

WELL PURPOSE: Home  
 (home, irrigation, municipal, industrial)

WELL COMPLETION DATA:

- (1) diameter (inches) 4"
- (2) total depth (feet) 95'
- (3) static water level (feet) 12' (below top of ground)
- (4) casing PVC 55'  
 (material) (depth)  
4" if telescope see back.  
 (size)
- (5) screen 40' 55'  
 (length) (depth to top)  
4" PVC  
 (size) (material)
- (6) pump 3 60  
 (HP) (yield gpm)  
ELECTRIC  
 (type power)
- (7) electric log No  
 (yes or no)

(organization running log)

(8) how well bottom plugged BACK WASH VALVE

DRILLERS REMARKS:

description of formations encountered

from to

<u>CLAY TOPSOIL</u>	<u>0</u>	<u>7</u>
<u>CLAY</u>	<u>7</u>	<u>21</u>
<u>SAND &amp; PEA GRAVEL</u>	<u>21</u>	<u>105</u>

**CODED**


**REGISTERED**  
**INSTRUMENT**

SEP 15 1975

MISS. RD. OF WATER COMM.

If well telescopes please  
sketch and show depths.

GROUND LEVEL

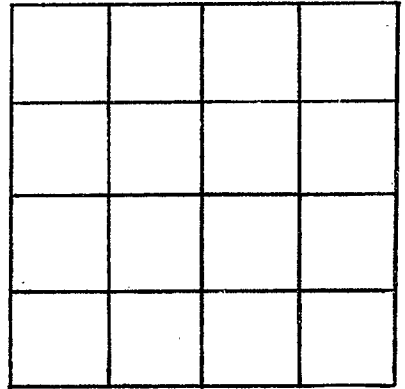

SECTION \_\_\_\_\_

Please indicate well location X.

ADDITIONAL INFORMATION

If more than one screen,  
show locations of each on sketch.