

QUITMAN
K42
9-21-77

MISSISSIPPI
BOARD OF WATER COMMISSIONERS
416 North State Street
Jackson, Mississippi 39201

CODED

WATER WELL DRILLERS LOG

9-21-1977 date well completed
FIVE COUNTY FARMERS-QUITMAN firm name
county well located

LANDOWNER: R. A. CARSON

description of formations encountered

from to

Mercha Miss.
(mailing address)

Clay	0	32
fine sand	32	51 1/2
sand & pec. area	51 1/2	115

WELL LOCATION:

sec 34 T26 N R 2 E
8 W

miles of (distance) (direction) (nearest town)

CODED

WELL PURPOSE: Irrigation
(home, irrigation, municipal, industrial)

WELL COMPLETION DATA:


- (1) diameter (inches) 8"
- (2) total depth (feet) 115
- (3) static water level (feet) 12 1/4" below top of ground
- (4) casing PVC, 7.5" (material) (depth)
If telescope see back.
(size)
- (5) screen 40' 7.5' (length) (depth to top)
8" 50.50" PVC (size) (material)
- (6) pump 1/2 (HP) 1200 (yield gpm)
(type power)
- (7) electric log 110 (yes or no)
(organization running log)
- (8) how well bottom plugged PVC CAP

DRILLERS REMARKS:

DECEMBER 15 1977
DOT 6 1977

If well telescopes please sketch and show depths.

GROUND LEVEL

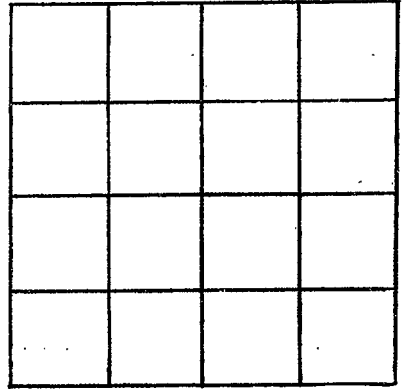

SECTION _____

Please indicate well location X.

ADDITIONAL INFORMATION

If more than one screen, show locations of each on sketch.