

QUITMAN
K44
3-14-78

MISSISSIPPI
BOARD OF WATER COMMISSIONERS CODED
416 North State Street
Jackson, Mississippi 39201
WATER WELL DRILLERS LOG

3-14 date well completed 1978 Fize Co. Farmers Ass firm name Quitman county well located

LANDOWNER: BA Carson
Lambert miss

description of formations encountered	from	to
top clay	0	17
fine sand	17	30
coarse sand	30	60
sand & silt	60	117

(mailing address)
WELL LOCATION:
sec. 2 T. 26(N) S R. 2 E W
3.5 miles S.W. of Lambert
(distance) (direction) (nearest town)

CODED

WELL PURPOSE: drigation
(home, irrigation, municipal, industrial)

- WELL COMPLETION DATA:
- (1) diameter (inches) 8"
 - (2) total depth (feet) 117
 - (3) static water level (feet) 13 ^{below}/_{above} top of ground.
 - (4) casing PVC, 77
(material) (depth)
 if telescope see back.
(size)
 - (5) screen 40', 77
(length) (depth to top)
8", PVC 50 flat
(size) (material)
 - (6) pump 30 1200
(HP) (yield gpm)
direct
(type power)
 - (7) electric log no
(yes or no)
 (organization running log)
 - (8) how well bottom plugged cap


RECEIVED
MAY 8 - 1978

DRILLERS REMARKS:

MISS. BD. OF WATER COMMISSIONERS

If well telescopes please sketch and show depths.

GROUND LEVEL

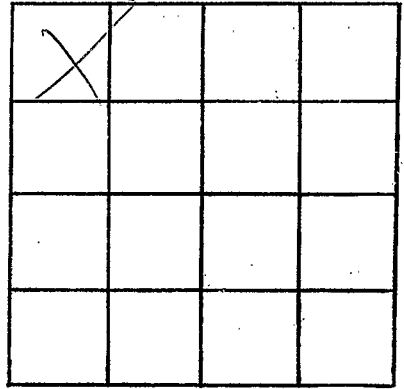

SECTION _____

Please indicate well location X.

ADDITIONAL INFORMATION

If more than one screen,
show locations of each on sketch.