

QUITMAN
K45
8/8/79
Elog # 28

MISSISSIPPI
BOARD OF WATER COMMISSIONERS
416 North State Street
Jackson, Mississippi 39201

CODED

WATER WELL DRILLERS LOG

August 8 1979 Bruce Berryman - Quitman
date well completed firm name county well located
Greenwood, Ms.

LANDOWNER: Olin Becker. Rt. 1. Box 587, Tutwiler. Miss. (mailing address)	description of formations encountered	from	to
WELL LOCATION: sec. 32 T 26 N R 2 E 8 miles W of TUTWILER (distance) (direction) (nearest town)	Clay	0	20
	Sand	20	80
	Sand & Gravel	80	110
	Sand & Str. Clay	110	280
	Sand	280	300
	Clay	300	305
	Sand	305	320
	Clay	320	460
	Sand & Str. Shale	460	520
	Sand	520	600
WELL PURPOSE: Home (home, irrigation, municipal, industrial)	Shale	600	660
	Sand & Str. shale	660	800
	Sand	800	830
	Clay	830	840
	Sand	840	860
	Clay	860	880
	Sand & Str. clay	880	900
	Sand & str. shale	900	960
	Sand (red water)	960	980
	Sandy shale	980	1010
WELL COMPLETION DATA: (1) diameter (inches) 4" x 2" (2) total depth (feet) 588 ft. (3) static water level (feet) 21 below top of ground 4" blk. - 126' (4) casing 2" galv - 441' (material) (depth) if telescope see back. (size) (5) screen 20' / 568' (length) (depth to top) .010 Stainless steel (size) (material) (6) pump 1 1/2 / 35 (HP) (yield gpm) Electric (type power) (7) electric log Yes (yes or no) Miss. Geo. Survey. (organization running log) (8) how well bottom plugged B.P.V.			


AUG 20 1979

RECEIVED

DRILLERS REMARKS: This well was first made at 982 ft. on May 17, 1979 but the water was RED so I had to pull pipe and reamed it and made well at 588 ft. Water was GOOD. Well completed Ag. 8, 1979.

If well telescopes please sketch and show depths.

GROUND LEVEL

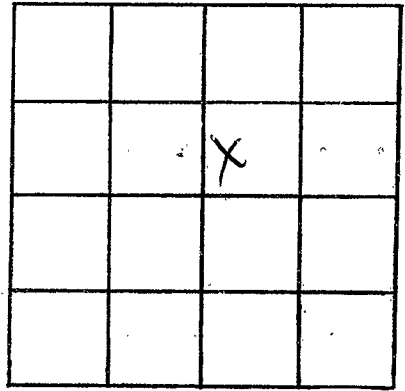

SECTION 32

Please indicate well location X.

ADDITIONAL INFORMATION

If more than one screen,
show locations of each on sketch.