

Quistman

MISSISSIPPI
BOARD OF WATER COMMISSIONERS
416 North State Street
Jackson, Mississippi 39201

CODED

WATER WELL DRILLERS LOG

K-46
1
6-2-80

6-2 19 80 Firm Co. Farms, Inc Quitman
date well completed firm name county well located

LANDOWNER: Sony Martin
Zutula Min

description of formations encountered	from	to
<u>top clay</u>	<u>0</u>	<u>8</u>
<u>Flint sand</u>	<u>4</u>	<u>24</u>
<u>Coar. sand</u>	<u>24</u>	<u>44</u>
<u>sand & silt</u>	<u>44</u>	<u>110</u>

(mailing address)

WELL LOCATION:
sec. 1 T 26 N S R 2 E W
3 miles west of Lumbert
(distance) (direction) (nearest town)

WELL PURPOSE:
(home, irrigation, municipal, industrial)

CODED

WELL COMPLETION DATA:

(1) diameter (inches) 16"

(2) total depth (feet) 110

(3) static water level (feet) 12 ^{below} above top of ground.

(4) casing Steel, 60'
(material) (depth)
16 if telescope see back.
(size)

(5) screen 50', 60'
(length) (depth to top)
16", Steel
(size) (material)

(6) pump 2 1/2 60 2400
(HP) (yield gpm)
Acorn
(type power)

(7) electric log no
(yes or no)

(organization running log)

(8) how well bottom plugged well

DEPT. OF NATURAL RESOURCES
BUREAU OF LAND & WATER RESOURCES


JUL 25 1980

RECEIVED

DRILLERS REMARKS:

If well telescopes please sketch and show depths.

GROUND LEVEL

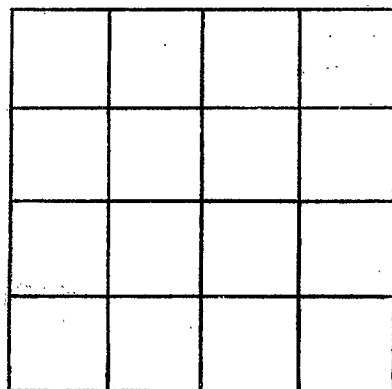

SECTION _____

Please indicate well location X.

ADDITIONAL INFORMATION

If more than one screen, show locations of each on sketch.