

Quintman  
K 48  
1-10-81


MISSISSIPPI  
BOARD OF WATER COMMISSIONERS  
416 North State Street  
Jackson, Mississippi 39201



WATER WELL DRILLERS LOG


7-10 date well completed 1981 firm name Five Co Formers Co. county well located Quintman

LANDOWNER: <u>Mr. Overboy</u> <u>Sambet miss</u>	description of formations encountered	from	to
(mailing address)	<u>Top clay</u>	6	8
WELL LOCATION: <u>2</u>	<u>Med Sand</u>	8	24
sec. <u>1</u> T <u>26</u> (N) R <u>4</u> (E) S (W)	<u>Core sand</u>	24	54
<u>2</u> miles <u>East</u> of <u>walnut</u> (distance) (direction) (nearest town)	<u>Sand &amp; Gra</u>	54	90
WELL PURPOSE: (home, irrigation, municipal, industrial)	<u>Big gra.</u>	90	116
WELL COMPLETION DATA:			
(1) diameter (inches) <u>16"</u>			
(2) total depth (feet) <u>110'</u>			
(3) static water level (feet) <u>14</u> <u>below</u> top of ground. <u>above</u>			
(4) casing <u>Steel</u> , <u>60</u> (material) (depth)			
<u>16"</u> if telescope see back. (size)			
(5) screen <u>50'</u> , <u>60'</u> (length) (depth to top)			
<u>16"</u> , <u>Steel - Browns</u> (size) (material)			
(6) pump <u>60</u> <u>3000</u> (HP) (yield gpm)			
<u>drum</u> (type power)			
(7) electric log <u>no</u> (yes or no)			
(organization running log)			
(8) how well bottom plugged <u>reworked</u>			
DRILLERS REMARKS:			

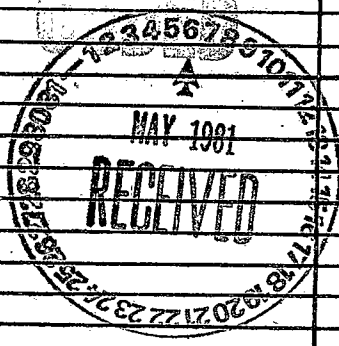

If well telescopes please sketch and show depths.

GROUND LEVEL

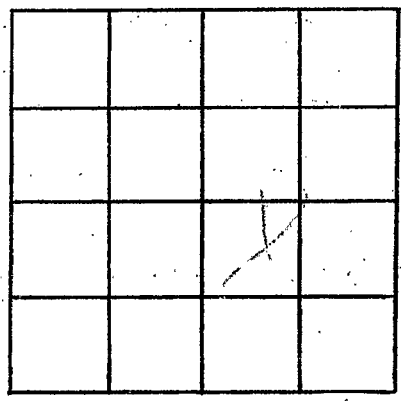

SECTION 1

Please indicate well location X.

ADDITIONAL INFORMATION

If more than one screen, show locations of each on sketch.