

MISSISSIPPI DEPARTMENT OF NATURAL RESOURCES

Bureau of Land and Water Resources

Southport Mall

P.O. Box 10631

Jackson, Mississippi 39209

WATER WELL DRILLERS LOG

CODED

Quitman
K 49
5-1-81

5-1 ⁸¹ W. M. Well Drilling Quitman
date well completed firm name county well located

LANDOWNER: J. R. Neal

description of formations encountered from to

(mailing address)

WELL LOCATION:
sec. 14 T 26 N R 2 E
S W
2 1/2 miles S of Walnut
(distance) (direction) (nearest town)


Clay 0 20
Sand 20 70
Gravel 70 100

WELL PURPOSE: Domestic
(home, irrigation, municipal, industrial)

CODED

WELL COMPLETION DATA:

- (1) diameter (inches) 6"
- (2) total depth (feet) 100
- (3) static water level (feet) 17 below above top of ground.
- (4) casing Plastic 100
(material) (depth)
- (size) if telescope see back.
- (5) screen 20 6
(length) (depth to top) (size)
- (6) pump 1/2 475
(HP) (yield gpm)
- Electric
(type power)
- (7) electric log No
(yes or no)

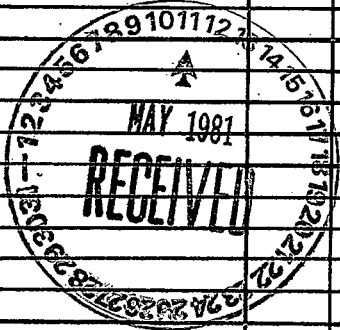

(organization running log)

(8) how well bottom plugged Cap

DRILLERS REMARKS:

If well telescopes please sketch and show depths.

GROUND LEVEL

SECTION _____

Please indicate well location X.

ADDITIONAL INFORMATION

If more than one screen, show locations of each on sketch.