

MISSISSIPPI DEPARTMENT OF NATURAL RESOURCES

Bureau of Land and Water Resources

Southport Mall

P.O. Box 10631

Jackson, Mississippi 39206

WATER WELL DRILLERS LOG

CODED

Quitman  
K51  
5/5/81

5-5-1981  
date well completed

Dyer  
firm name

Quitman  
county well located

LANDOWNER:

Billy Vandell  
Vance, MS.  
(mailing address)

description of formations encountered

from to

<u>clay</u>	<u>0</u>	<u>26</u>
<u>fine sand</u>	<u>26</u>	<u>46</u>
<u>sand &amp; gravel</u>	<u>46</u>	<u>101</u>

WELL LOCATION:


sec. 35 T. 2 N. R. H E.  
S. W  
1 miles W of Vance  
(distance) (direction) (nearest town)

WELL PURPOSE: Drinking  
(home, irrigation, municipal, industrial)

WELL COMPLETION DATA:

- (1) diameter (inches) 16"
- (2) total depth (feet) 101'
- (3) static water level (feet) 21 below above top of ground.
- (4) casing Steel (material), 113' (depth)  
16" if telescope see back. (size)
- (5) screen 40' (length), 21' (depth to top)  
16" (size), Steel (material)
- (6) pump 80 (HP), 1200 (yield gpm)  
Diesel (type power)
- (7) electric log                      (yes or no)  
   (organization running log)
- (8) how well bottom plugged plate


CODED

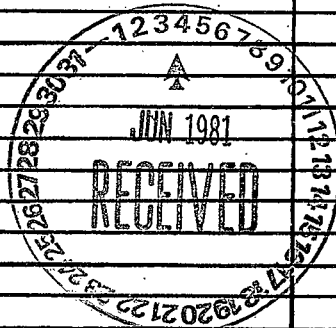

DRILLERS REMARKS:

If well telescopes please sketch and show depths.

GROUND LEVEL

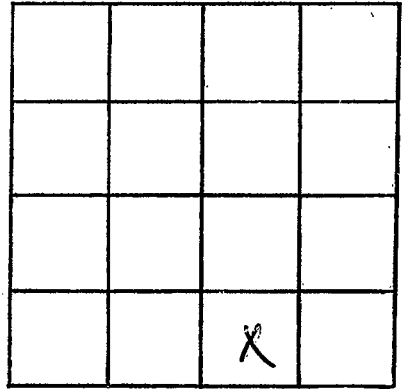

SECTION 35

Please indicate well location X.

ADDITIONAL INFORMATION

If more than one screen,  
show locations of each on sketch.