

MISSISSIPPI DEPARTMENT OF NATURAL RESOURCES

Bureau of Land and Water Resources

Southport Mall

P.O. Box 10631

Jackson, Mississippi 39209

WATER WELL DRILLERS LOG

CODED

Quitman
R 53
CL-1774
4-29-81

4-29-81 19
date well completed

Layne-Central Co.
firm name

Quitman
county well located

LANDOWNER:	description of formations encountered	from	to
<u>West End Planting Company</u>	<u>Clay</u>	<u>0</u>	<u>17</u>
	<u>Coarse sand</u>	<u>17</u>	<u>59</u>
<u>Vance, MS</u>	<u>Coarse sand & P. Gr.</u>	<u>59</u>	<u>70</u>
(mailing address)	<u>Coarse sand & Gravel</u>	<u>70</u>	<u>95</u>
	<u>Coarse sand & Boulders</u>	<u>95</u>	<u>97</u>

WELL LOCATION:
sec. 21 T. 26 N R. 2 W
4 miles N.W. of VANCE
(distance) (direction) (nearest town)

WELL PURPOSE: irrigation
(home, irrigation, municipal, industrial)

- WELL COMPLETION DATA:
- (1) diameter (inches) 32"
 - (2) total depth (feet) 97'
 - (3) static water level (feet) 10' below above top of ground.
 - (4) casing Steel 57'
(material) (depth)
 - 16" If telescope see back.
(size)
 - (5) screen 40' 57'
(length) (depth to top)
 - 16" St. Steel
(size) (material)
 - (6) pump 50 2400
(HP) (yield gpm)
 - DIESEL
(type power)
 - (7) electric log no
(yes or no)

CODED

(organization running log)

(8) how well bottom plugged st. plate

DRILLERS REMARKS:


DEPT. OF NATURAL RESOURCES
BUREAU OF LAND & WATER RESOURCES

OCT 20 1981

RECEIVED

If well telescopes please sketch and show depths.

GROUND LEVEL

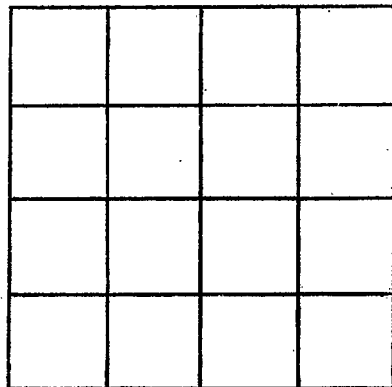

SECTION _____

Please indicate well location X.

ADDITIONAL INFORMATION

If more than one screen,
show locations of each on sketch.