

MISSISSIPPI DEPARTMENT OF NATURAL RESOURCES

Bureau of Land and Water Resources

Southport Mall

P.O. Box 10631

Jackson, Mississippi 39209

WATER WELL DRILLERS LOG

CODED

Quitman
 CL-1774
K 54
4-27-81

4-27 1981 LAYNE-CENTRAL CO. Quitman
 date well completed firm name county well located

LANDOWNER:	description of formations encountered	from	to
West End Planting Co.	clay	0	16
Vance, MS	sand	16	25
(mailing address)	c.sand & p. gravel	25	38
	c. sand	38	70

WELL LOCATION:	description of formations encountered	from	to
sec. <u>21-36</u> N R. <u>2</u> W	c.sand & p.gravel	70	83
<u>4</u> miles <u>N.W.</u> of <u>VANCE</u>	c.sand & gravel	83	95
(distance) (direction) (nearest town)	c.sand & boulders	95	112

WELL PURPOSE: irrigation
 (home, irrigation, municipal, industrial)

WELL COMPLETION DATA:

(1) diameter (inches) 32"

(2) total depth (feet) 110'

(3) static water level (feet) 10' below above top of ground.

(4) casing steel 60'
 (material) (depth)
16" if telescope see back.
 (size)

(5) screen 50' 60'
 (length) (depth to top)
16"
 (size) (material)

(6) pump 25 2400
 (HP) (yield gpm)
DIESEL
 (type power)

(7) electric log no
 (yes or no)

(organization running log)

(8) how well bottom plugged st. plate

DRILLERS REMARKS:

CODED


DEPT. OF NATURAL RESOURCES
 BUREAU OF LAND & WATER RESOURCES

OCT 20 1981

RECEIVED

If well telescopes please sketch and show depths.

GROUND LEVEL

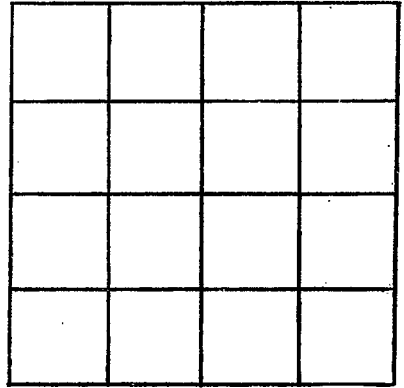

SECTION _____

Please indicate well location X.

ADDITIONAL INFORMATION

If more than one screen,
show locations of each on sketch.