

QUITMAN
K56
11/14/81

MISSISSIPPI DEPARTMENT OF NATURAL RESOURCES
Bureau of Land and Water Resources
Southport Mall
P.O. Box 10631
Jackson, Mississippi 39209
WATER WELL DRILLERS LOG

CODED

12-14 1981 U. Dist. Drilling Co Quitman
date well completed firm name county well located

LANDOWNER: <u>S.M. Frewell Co</u>	description of formations encountered	from	to
<u>Box 159</u>	<u>Clay</u>	<u>0</u>	<u>16</u>
<u>Waver MS</u> (mailing address)	<u>fine sand</u>	<u>16</u>	<u>45</u>
WELL LOCATION: sec. <u>13</u> T <u>26</u> N R <u>2</u> E S W	<u>Rough sandstone</u>	<u>15</u>	<u>100</u>
<u>10</u> miles <u>SW</u> of <u>Lambert</u> (distance) (direction) (nearest town)			
WELL PURPOSE: <u>Industrial</u> (home, irrigation, municipal, industrial)			
WELL COMPLETION DATA:			
(1) diameter (inches) <u>12"</u>			
(2) total depth (feet) <u>100</u>			
(3) static water level (feet) <u>16</u> below top of ground			
(4) casing <u>5 1/2"</u> <u>60'</u> (material) (depth)			
<u>12</u> if telescope see back. (size)			
(5) screen <u>40'</u> <u>60'</u> (length) (depth to top)			
<u>12</u> <u>steel</u> (size) (material)			
(6) pump <u>100</u> <u>1400</u> (HP) (yield gpm)			
<u>Direct</u> (type power)			
(7) electric log <u>N</u> (yes or no)			
(organization running log)			
(8) how well bottom plugged <u>plate</u>			
DRILLERS REMARKS:			


CODED

DEPT. OF NATURAL RESOURCES
BUREAU OF LAND & WATER RESOURCES

DEC 10 1981
RECEIVED

If well telescopes please sketch and show depths.

GROUND LEVEL

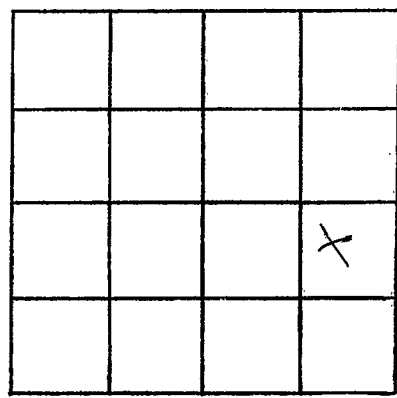

SECTION 13

Please indicate well location X.

ADDITIONAL INFORMATION

If more than one screen, show locations of each on sketch.