

MISSISSIPPI DEPARTMENT OF NATURAL RESOURCES

Bureau of Land and Water Resources

Southport Mall

P.O. Box 10631

Jackson, Mississippi 39209

WATER WELL DRILLERS LOG

CODED

QUITMAN  
 1557  
 3/20/83

3/20/83 19  
 date well completed

Powell Irrigation  
 firm name

Quitman  
 county well located

LANDOWNER:  
 Yandell  
 Vance, MS  
 (mailing address)

description of formations encountered

from

to

Topsoil + Clay	1	35
COARSE SAND	35	80
SAND + GRAVEL	80	113

WELL LOCATION:  
 sec. 25 T 26 N R 2 E  
 S W  
 1 miles NW of VANCE  
 (distance) (direction) (nearest town)

WELL PURPOSE: Irrigation  
 (home, irrigation, municipal, industrial)

WELL COMPLETION DATA:

(1) diameter (inches) 16

(2) total depth (feet) 113

(3) static water level (feet) 15 <sup>below</sup> <sub>above</sub> top of ground.

(4) casing Steel, 73  
 (material) (depth)  
 16 (size) if telescope see back.

(5) screen 40, 73  
 (length) (depth to top)  
 16, steel  
 (size) (material)

(6) pump 100, 1200  
 (HP) (yield gpm)  
 Diesel  
 (type power)

(7) electric log NO  
 (yes or no)  
 (organization running log)

(8) how well bottom plugged  
 Steel plate

CODED

DEPT. OF NATURAL RESOURCES  
 BUREAU OF LAND & WATER RESOURCES


MAY 20 1983

RECEIVED

DRILLERS REMARKS:

If well telescopes please sketch and show depths.

GROUND LEVEL

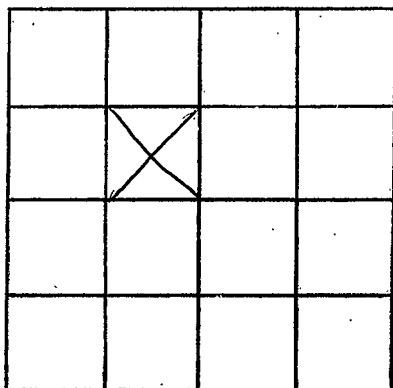

SECTION 25

Please indicate well location X.

ADDITIONAL INFORMATION

If more than one screen, show locations of each on sketch.