

MISSISSIPPI DEPARTMENT OF NATURAL RESOURCES

Bureau of Land and Water Resources

Southport Mall

P.O. Box 10631

Jackson, Mississippi 39209

WATER WELL DRILLERS LOG

CODED

Quitman  
R K 59  
4/8/82

4/8-82 19  
 date well completed

Power Irrigation  
 firm name

Quitman  
 county well located

LANDOWNER: <u>LOVELAND T. VANEE</u>	description of formations encountered	from	to
<u>Uanee, Miss</u> (mailing address)	<u>CLAY</u>	<u>0</u>	<u>15</u>
WELL LOCATION: sec. <u>34</u> <u>T20N</u> <u>R2E</u> <u>S</u> <u>W</u>	<u>FINE SAND</u>	<u>15</u>	<u>33</u>
<u>2</u> miles <u>West</u> of <u>Uanee</u> (distance) (direction) (nearest town)	<u>COARSE SAND AND GRAVEL</u>	<u>33</u>	<u>113</u>
WELL PURPOSE: <u>Irrigation</u> (home, irrigation, municipal, industrial)			
WELL COMPLETION DATA:			
(1) diameter (inches) <u>16"</u>			
(2) total depth (feet) <u>113"</u>			
(3) static water level (feet) <u>15'</u> below above top of ground.			
(4) casing <u>steel</u> , <u>73</u> (material) (depth) (size) if telescope see back.			
(5) screen <u>40"</u> , <u>73</u> (length) (depth to top) <u>16</u> , <u>steel</u> (size) (material)			
(6) pump <u>40</u> <u>2000</u> (HP) (yield gpm) <u>Diesel</u> (type power)			
(7) electric log <u>NO</u> (yes or no) (organization running log)			
(8) how well bottom plugged <u>steel plate</u>			
DRILLERS REMARKS:			


DEPT. OF NATURAL RESOURCES  
 BUREAU OF LAND & WATER RESOURCES

JUN - 4 1982

RECEIVED

If well telescopes please sketch and show depths.

GROUND LEVEL

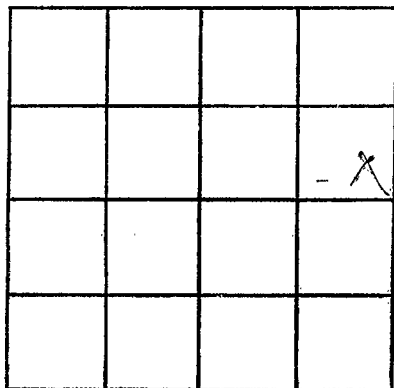

SECTION 34

Please indicate well location X.

ADDITIONAL INFORMATION

If more than one screen, show locations of each on sketch.