

MISSISSIPPI DEPARTMENT OF NATURAL RESOURCES

Bureau of Land and Water Resources

Southport Mall

P.O. Box 10631

Jackson, Mississippi 39209

CODED

WATER WELL DRILLERS LOG

BUTANE GAS COMPANY

OF GREENWOOD

firm name

county well located

Quitman  
K 60  
12/29/82

12-29-82  
date well completed

Quitman  
~~Quitman~~

LANDOWNER:  
Mike Shurtcut Jr  
(mailing address)

description of formations encountered	from	to
Clay	0	10
Sand	10	30
Sand & gravel	30	103

WELL LOCATION:  
sec. 35 T 26 N R 2 E  
8 W  
2 miles NW of Vance  
(distance) (direction) (nearest town)

WELL PURPOSE: drinking  
(home, irrigation, municipal, industrial)

- WELL COMPLETION DATA:
- (1) diameter (inches) 16"
  - (2) total depth (feet) 103
  - (3) static water level (feet) \_\_\_\_\_ below/above top of ground.
  - (4) casing Steel, 63' (material), (depth)  
16 if telescope see back. (size)
  - (5) screen 40, 63' (length), (depth to top)  
16, Steel (size), (material)
  - (6) pump 60, 1500 (HP), (yield gpm)  
Diesel (type power)
  - (7) electric log No (yes or no)  
No (organization running log)
  - (8) how well bottom plugged gravel steel plate

DEPT. OF NATURAL RESOURCES  
BUREAU OF LAND & WATER RESOURCES


JAN 17 1983

RECEIVED

DRILLERS REMARKS:  
Josi

If well telescopes please sketch and show depths.

GROUND LEVEL

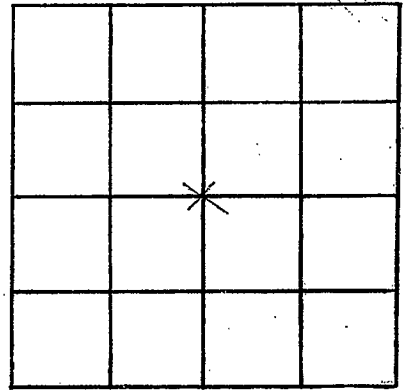

SECTION 35

Please indicate well location X.

ADDITIONAL INFORMATION

If more than one screen,  
show locations of each on sketch.