

MISSISSIPPI DEPARTMENT OF NATURAL RESOURCES
 Bureau of Land and Water Resources
 Southport Mall
 P.O. Box 10631
 Jackson, Mississippi 39209
WATER WELL DRILLERS LOG

K62
Quitman
3-10-84

CODED

3/10/84 19 Powell Irrigation Quitman
 date well completed firm name county well located

LANDOWNER:
Jim Wilburn
Vance, MS
 (mailing address)

description of formations encountered	from	to
CLAY	0	23
FINE SAND	23	63
COARSE SAND & GRAVEL	63	113

WELL LOCATION:
 sec. 35 T 26 (N) R 2 E
 S (W)
1/2 miles West of Vance
 (distance) (direction) (nearest town)

WELL PURPOSE: Irrigation
 (home, irrigation, municipal, industrial)

WELL COMPLETION DATA:

(1) diameter (inches) 16"

(2) total depth (feet) 113'

(3) static water level (feet) 14' below above top of ground.

(4) casing Steel, 73'
 (material) (depth)
 _____ if telescope see back.
 (size)

(5) screen 40', 73'
 (length) (depth to top)
16", Steel
 (size) (material)

(6) pump 60 1400
 (HP) (yield gpm)
Diesel
 (type power)

(7) electric log NO
 (yes or no)

 (organization running log)

(8) how well bottom plugged Steel Plate

DRILLERS REMARKS:


DEPT. OF NATURAL RESOURCES
 BUREAU OF LAND & WATER RESOURCES

MAR 28 1984

RECEIVED

If well telescopes please sketch and show depths.

GROUND LEVEL

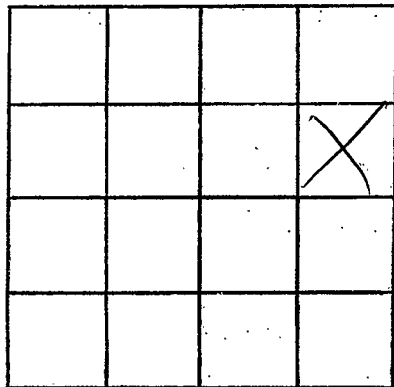

SECTION 35

Please indicate well location X.

ADDITIONAL INFORMATION

If more than one screen,
show locations of each on sketch.