

MISSISSIPPI DEPARTMENT OF NATURAL RESOURCES

Bureau of Land and Water Resources

Southport Mall

P.O. Box 10631

Jackson, Mississippi 39209

CODED

WATER WELL DRILLERS LOG

K63  
 Quitman  
 8-15-84

8/84 19 Powell IRRIGATION Quitman  
 date well completed firm name county well located

LANDOWNER:  
 R. A. CARSON  
 (mailing address)

description of formations encountered	from	to
CLAY	0	20
COARSE SAND	20	50
COARSE SAND + GRAVEL	50	100

WELL LOCATION:  
 sec. 35 T 26 N R. 2 E  
 5 1/2 miles SW of Lambert  
 (distance) (direction) (nearest town)

WELL PURPOSE: IRRIGATION  
 (home, irrigation, municipal, industrial)

WELL COMPLETION DATA:

(1) diameter (inches) 12

(2) total depth (feet) 100

(3) static water level (feet) 15 below above top of ground.

(4) casing Steel 60 (material) (depth)  
 (size) if telescope see back.

(5) screen 40 60 (length) (depth to top)  
 12 Steel (size) (material)

(6) pump 60 2000 (HP) (yield gpm)  
 Diesel (type power)

(7) electric log No (yes or no)  
 (organization running log)

(8) how well bottom plugged Steel PLATE

DEPT. OF NATURAL RESOURCES  
 BUREAU OF LAND & WATER RESOURCES


NOV 29 1984

DRILLERS REMARKS:

RECEIVED

If well telescopes please sketch and show depths.

GROUND LEVEL

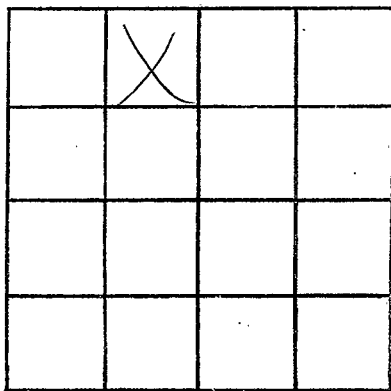

SECTION 35

Please indicate well location X.

ADDITIONAL INFORMATION

If more than one screen,  
show locations of each on sketch.