

MISSISSIPPI DEPARTMENT OF NATURAL RESOURCES  
Bureau of Land and Water Resources

Southport Mall

P.O. Box 10631

Jackson, Mississippi 39209

CODED

WATER WELL DRILLERS LOG

K6A  
Quitman  
7-15-84

7/84 19 Powell Quitman  
date well completed firm name county well located

LANDOWNER:  
Jim Wilbourn  
(mailing address)

description of formations encountered	from	to
CLAY	0	10
Med SAND	10	40
Med & COARSE SAND	40	60
COARSE SAND & GRAVEL	60	100

WELL LOCATION:  
sec. 34 T 26 N R 2 E  
S W  
2 miles W of VANCE  
(distance) (direction) (nearest town)

WELL PURPOSE: IRRIGATION  
(home, irrigation, municipal, industrial)

WELL COMPLETION DATA:

(1) diameter (inches) 16

(2) total depth (feet) 100

(3) static water level (feet) 25 below above top of ground.

(4) casing Steel, 60  
(material) (depth)

(size) If telescope see back.

(5) screen 40, 60  
(length) (depth to top)

16, Steel  
(size) (material)

(6) pump 80, 1500  
(HP) (yield gpm)

Diesel  
(type power)

(7) electric log NO  
(yes or no)

(organization running log)

(8) how well bottom plugged Steel PATE

DRILLERS REMARKS:


DEPT. OF NATURAL RESOURCES  
BUREAU OF LAND & WATER RESOURCES

NOV 29 1984

RECEIVED

If well telescopes please sketch and show depths.

GROUND LEVEL

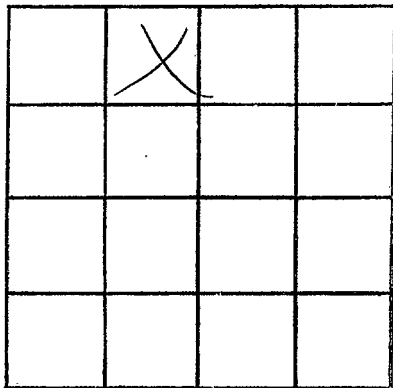

SECTION 34

Please indicate well location X.

ADDITIONAL INFORMATION

If more than one screen,  
show locations of each on sketch.