

MISSISSIPPI DEPARTMENT OF NATURAL RESOURCES

Bureau of Land and Water Resources

Southport Mall

P.O. Box 10631

CODED

Jackson, Mississippi 39209

WATER WELL DRILLERS LOG

K 65
 Quinman
 8/21/84

8/21/84 19 *Quinman* firm name *Quinman* county well located

LANDOWNER: *Billy Gordell*
 (mailing address)

description of formations encountered	from	to
<i>Clay</i>	<i>0</i>	<i>28</i>
<i>fine sand</i>	<i>28</i>	<i>80</i>
<i>sand + gravel</i>	<i>80</i>	<i>102</i>

WELL LOCATION:
 sec *26* T *26* N R *2* E
S miles *5* miles *W* of *Yancey*
 (distance) (direction) (nearest town)

WELL PURPOSE: *Drainage*
 (home, irrigation, municipal, industrial)

WELL COMPLETION DATA:

(1) diameter (inches) *16"*

(2) total depth (feet) *102*

(3) static water level (feet) *18* below above top of ground.

(4) casing *STEEL*, *102*,
 (material) (depth)
16" If telescope see back.
 (size)

(5) screen *40ft*, *102*
 (length) (depth to top)
16", *STEEL*
 (size) (material)

(6) pump *80*, *3200*
 (HP) (yield gpm)

DIES
 (type power)

(7) electric log *No*
 (yes or no)
No
 (organization running log)


(8) how well bottom plugged
STEEL PLATE

DRILLERS REMARKS:

11-11-84
W.W.

If well telescopes please sketch and show depths.

GROUND LEVEL

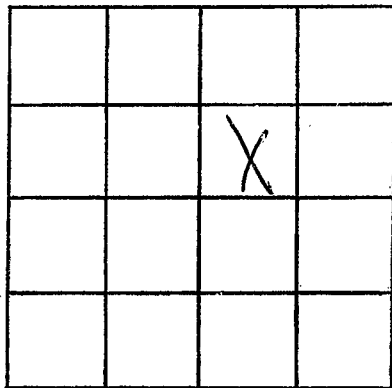

SECTION 28

Please indicate well location X.

ADDITIONAL INFORMATION

If more than one screen,
show locations of each on sketch.