

MISSISSIPPI DEPARTMENT OF NATURAL RESOURCES

Bureau of Land and Water Resources

Southport Mall

P.O. Box 10631

CODED

Jackson, Mississippi 39209

WATER WELL DRILLERS LOG QUITMAN

K66
~~COAHOMA~~ QUITMAN
3-22-85

3-22 19 85 POWELL IRR ~~COAHOMA~~
date well completed firm name county well located

LANDOWNER:
LARRY MASTERS
VANCE, MS
(mailing address)

description of formations encountered	from	to
<u>Clay</u>	<u>0</u>	<u>20</u>
<u>Clay & Fine Sand</u>	<u>20</u>	<u>50</u>
<u>Fine Sand</u>	<u>50</u>	<u>60</u>
<u>Fine & Coarse</u>	<u>60</u>	<u>70</u>
<u>Coarse & Med Sand</u>	<u>70</u>	<u>80</u>
<u>COARSE SAND</u>	<u>80</u>	<u>97</u>

WELL LOCATION:
sec 33 T 26 N R 2 E
5 miles West of VANCE
(distance) (direction) (nearest town)

WELL PURPOSE: IRRIGATION
(home, irrigation, municipal, industrial)

- WELL COMPLETION DATA:
- (1) diameter (inches) 16
 - (2) total depth (feet) 97
 - (3) static water level (feet) 12 below above top of ground.
 - (4) casing Steel, 57,
(material) (depth)
16 if telescope see back.
(size)
 - (5) screen 40, 57
(length) (depth to top)
16, steel
(size) (material)
 - (6) pump 40, 2000
(HP) (yield gpm)
Diesel
(type power)
 - (7) electric log NO
(yes or no)

(organization running log)


(8) how well bottom plugged Steel
PLATE

DRILLERS REMARKS:

RECEIVED
APR 22 1985

If well telescopes please sketch and show depths.

GROUND LEVEL

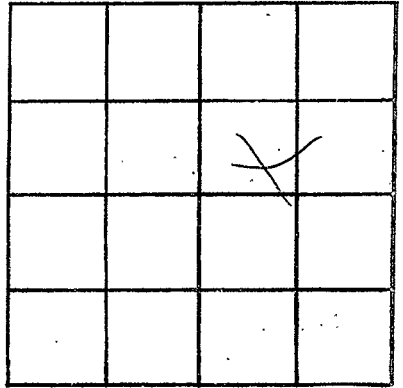

SECTION 33

Please indicate well location X.

ADDITIONAL INFORMATION

If more than one screen,
show locations of each on sketch.