

MISSISSIPPI DEPARTMENT OF NATURAL RESOURCES

Bureau of Land and Water Resources

Southport Mall

P.O. Box 10631

Jackson, Mississippi 39209

WATER WELL DRILLERS LOG

K 67  
Quitman

3-14 19 85 Baton Rouge La. Quitman  
date well completed firm name county well located

LANDOWNER:  
M. P. Sturdivant  
Greenwood, Miss.  
(mailing address)

description of formations encountered	from	to
	Clay	0
peal gravel	55	75
sand & gravel	75	113

WELL LOCATION:  
sec. 25 T 26 N R 2 E S W  
2.5 miles NW of VANCE  
(distance) (direction) (nearest town)

WELL PURPOSE: Irrigation  
(home, irrigation, municipal, industrial)

- WELL COMPLETION DATA:
- (1) diameter (inches) 16"
  - (2) total depth (feet) 113
  - (3) static water level (feet) 23 below above top of ground.
  - (4) casing steel 73' (material) (depth)  
16" if telescope see back. (size)
  - (5) screen 40' 73 (length) (depth to top)  
16" steel (size) (material)
  - (6) pump 60 2200 (HP) (yield gpm)  
Diesel (type power)
  - (7) electric log No (yes or no)  
No (organization running log)
  - (8) how well bottom plugged, Steel plate


RECEIVED  
MAY - 2 1985

DRILLERS REMARKS:  
Carlos Ramos

Department of Natural Resources  
Bureau of Land & Water Resources

If well telescopes please sketch and show depths.

GROUND LEVEL

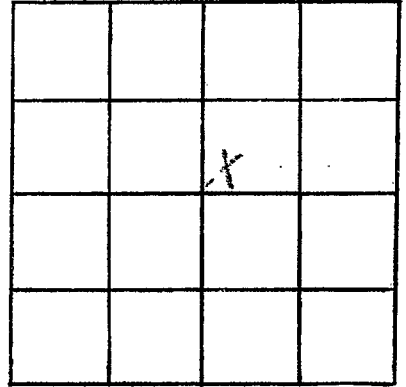

SECTION 25

Please indicate well location X.

ADDITIONAL INFORMATION

A series of horizontal lines for entering additional information, starting below the 'ADDITIONAL INFORMATION' header and extending to the bottom of the page.

If more than one screen, show locations of each on sketch.