

MISSISSIPPI DEPARTMENT OF NATURAL RESOURCES

Bureau of Land and Water Resources

Southport Mall

P.O. Box 10631

Jackson, Mississippi 39209 **CODED**

WATER WELL DRILLERS LOG

QUITMAN
K68

8-7
date well completed

1988 BUTANE GAS COMPANY
OF GREENWOOD

Quitman
county well located

LANDOWNER:
Mike Stuidewant
Vance Ms.
(mailing address)

description of formations encountered	from	to
CLAY	0	12
CLAY & Red gravel	12	40
gravel & SAND	40	106

WELL LOCATION:

sec. 21 T 26 N R 2 E
S W
4 miles NW of VANCE
(distance) (direction) (nearest town)

WELL PURPOSE:
(home, irrigation, municipal, industrial)

WELL COMPLETION DATA:

- (1) diameter (inches) 16"
- (2) total depth (feet) 106
- (3) static water level (feet) 18 below above top of ground.
- (4) casing steel 66
(material) (depth)
16" if telescope see back.
(size)
- (5) screen 40' 66
(length) (depth to top)
16" steel
(size) (material)
- (6) pump 60 2500
(HP) (yield gpm)
Diesel
(type power)
- (7) electric log No
(yes or no)
No
(organization running log)
- (8) how well bottom plugged
steel plate

RECEIVED


AUG - 5 1985

Department of Natural Resources
Bureau of Land & Water Resources

DRILLERS REMARKS:
Revised CARLOS

If well telescopes please sketch and show depths.

GROUND LEVEL

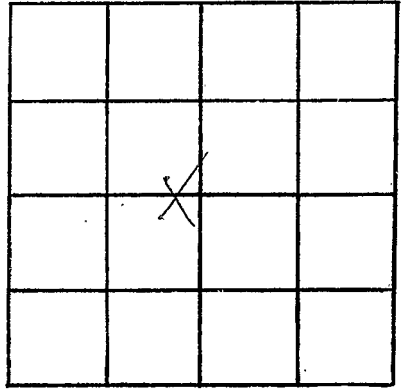

SECTION 21

Please indicate well location X.

ADDITIONAL INFORMATION

If more than one screen,
show locations of each on sketch.