

MISSISSIPPI DEPARTMENT OF NATURAL RESOURCES

Bureau of Land and Water Resources

Southport Mall

P.O. Box 10631

Jackson, Mississippi 39209

WATER WELL DRILLERS LOG

Quinn
K 70
7/86

CODED

7/8/86 date well completed
Powell Drigiter firm name
Quinn Cochran county well located

LANDOWNER:
Flowers Farms
Tunica MS 39676
(mailing address)

description of formations encountered
Clay
Coarse sand & gravel
from 0.23 to 2.3105

WELL LOCATION:
sec. 17 T 26 N R 2 E
8 miles NE of NATISSON
(distance) (direction) (nearest town)

WELL PURPOSE: drinking
(home, irrigation, municipal, industrial)

WELL COMPLETION DATA:
(1) diameter (inches) 12
(2) total depth (feet) 105
(3) static water level (feet) 14 below above top of ground.
(4) casing Steel 65
(material) (depth)
(size) if telescope see back.
(5) screen 40 65
(length) (depth to top)
12 Steel
(size) (material)
(6) pump 60 1500
(HP) (yield gpm)
diesel
(type power)
(7) electric log No
(yes or no)
(organization running log)
(8) how well bottom plugged
Steel plate

CODED

RECEIVED


OCT 27 1986

Department of Natural Resources
Bureau of Land & Water Resources

DRILLERS REMARKS:
86028 CMG01-04

If well telescopes please
sketch and show depths.

GROUND LEVEL

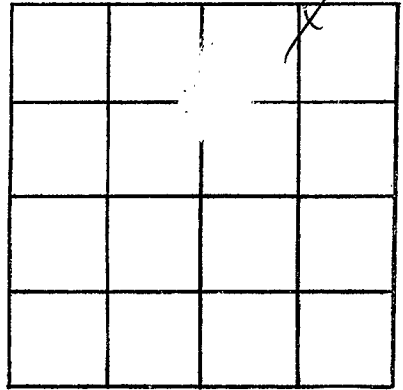

SECTION 17

Please indicate well location X.

ADDITIONAL INFORMATION

If more than one screen,
show locations of each on sketch.