

MISSISSIPPI DEPARTMENT OF NATURAL RESOURCES

Bureau of Land and Water Resources

Southport Mall

P.O. Box 10631

Jackson, Mississippi 39209

WATER WELL DRILLERS LOG

Quitman  
K 71  
8/86

CODED

*Quinn*  
*Cochran*

8/86 date well completed

Powell firm name

county well located

LANDOWNER:  
Flowers Farms  
Junica MS 38676  
(mailing address)

description of formations encountered	from	to
CLAY	0	23
COARSE SAND & GRAVEL	23	105

WELL LOCATION:  
sec 17 T 26 N R 2 E  
8 miles NE of MATISON  
(distance) (direction) (nearest town)

WELL PURPOSE: *Drinking*  
(home, irrigation, municipal, industrial)

WELL COMPLETION DATA:

(1) diameter (inches) 12

(2) total depth (feet) 105

(3) static water level (feet) 14 below top of ground.

(4) casing Steel 65  
(material) (depth)  
(size) If telescope see back.

(5) screen 40 65  
(length) (depth to top)  
12 Steel  
(size) (material)

(6) pump 60 1500  
(HP) (yield gpm)  
diesel  
(type power)

(7) electric log NO  
(yes or no)  
(organization running log)

(8) how well bottom plugged  
Steel PLATE

CODED

RECEIVED


OCT 27 1996

Department of Natural Resources  
Bureau of Land & Water Resources

DRILLERS REMARKS:  
86028CMG-01-05

If well telescopes please sketch and show depths.

GROUND LEVEL

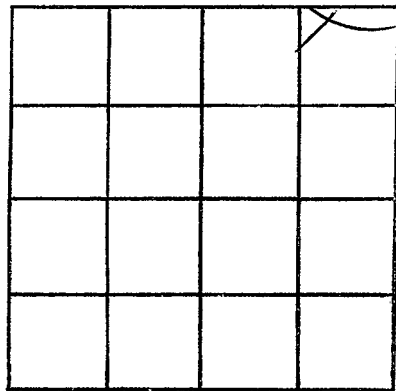

SECTION 17

Please indicate well location X.

ADDITIONAL INFORMATION

If more than one screen,  
show locations of each on sketch.