

MISSISSIPPI DEPARTMENT OF NATURAL RESOURCES

Bureau of Land and Water Resources

COUNTY WELL LOCATED
Quitman

WELL NUMBER **K 73** CODED

DATE WELL COMPLETED **9/88**

PERMIT NUMBER

NAME OF DRILLING FIRM
Dowd Drilling
Box 200
Clarksdale MS

CODED

P.O. Box 10631
 Jackson, Mississippi 39209
WATER WELL DRILLERS LOG

NAME & MAILING ADDRESS OF LANDOWNER
Dick Flowers
Jackson MS

WELL LOCATION: SEC **8** TOWNSHIP **26** RANGE **2** **N** **W**

DISTANCE **5** Miles DIRECTION **NE** NEAREST TOWN **Mattson**

OTHER LANDMARK

WELL PURPOSE: Home **Irrigation**, Municipal, Industrial, Fish Pond, etc.

PUMP DATA

PUMP TYPE (Circle One):
 Submersible, **Turbine**, Jet, Flowing Well,
 Other (Describe) _____

POWER TYPE (Circle One):
 Electric, Tractor, **Diesel**, Gasoline, Butane,
 Other (Describe) _____

Pump Capacity (GPM) **1400** No. of Stages **3** Setting Depth **50** FT.

PUMP TEST
 Well yielded **1400** GPM with
 a drawdown of _____ ft.
 after _____ hours of pumping

WELL DATA

Well Depth 100'	Casing Diameter (In.) 12"	Casing Length (Ft.) 60'
Type of Casing Steel	Hole Depth 100'	Depth to Static Water Level 16'

TYPE OF COMPLETION: (Circle One or More):
 Gravel Packed, Underreamed, Telescoped,
 Natural Development, Open Hole, Other
 (Describe) _____

Top of Lap Pipe or Reduction in Casing

FEET IF TELESCOPED OR MORE THAN ONE SCREEN: USE BACK PAGE

LOG DATA

TYPE OF LOG RUN (Circle One):
 No Log Run, Electric, Gamma Ray, Density, Sonic, Neutron,
 Other (Describe) _____

Name of Organization Running Log

SCREEN DATA

Diameter - Inches 12"	Length - Feet 40'	Slot Size - Inches 1030
Screen Type Steel	Depth to Bottom - Feet 100'	

GEOLOGIC DATA (Office Use Only)

Surface Elev.	Geologic Unit	Unit Thickness	Depth to Top
Subs. SWL	Date	Analysis	Aquifer Test


Driller's Remarks

DESCRIPTION OF FORMATIONS ENCOUNTERED	FROM	TO	FORMATIONS (Continued)	FROM	TO
Clay	0	20	<div style="font-size: 3em; font-weight: bold; opacity: 0.5;">RECEIVED</div> <p style="font-size: 1.5em; font-weight: bold;">SEP 22 1988</p> <p style="font-size: 0.8em;">Department of Natural Resources Bureau of Land & Water Resources</p>		
fine sand	20	40			
coarse sand	40	100			
+ gravel					

IF MORE SPACE IS NEEDED, USE BACK

If well telescopes please sketch and show depths.

GROUND LEVEL

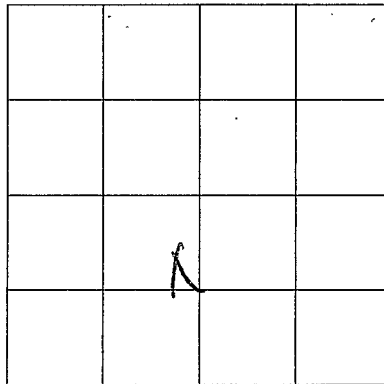

SECTION 8

Please indicate well location X.

ADDITIONAL INFORMATION

Lined area for providing additional information.

If more than one screen, show location of each on sketch.